


Section 35 Township 17 Range 11W

Well No. #1 J. Moran

Company Honaker & R. J. Shields

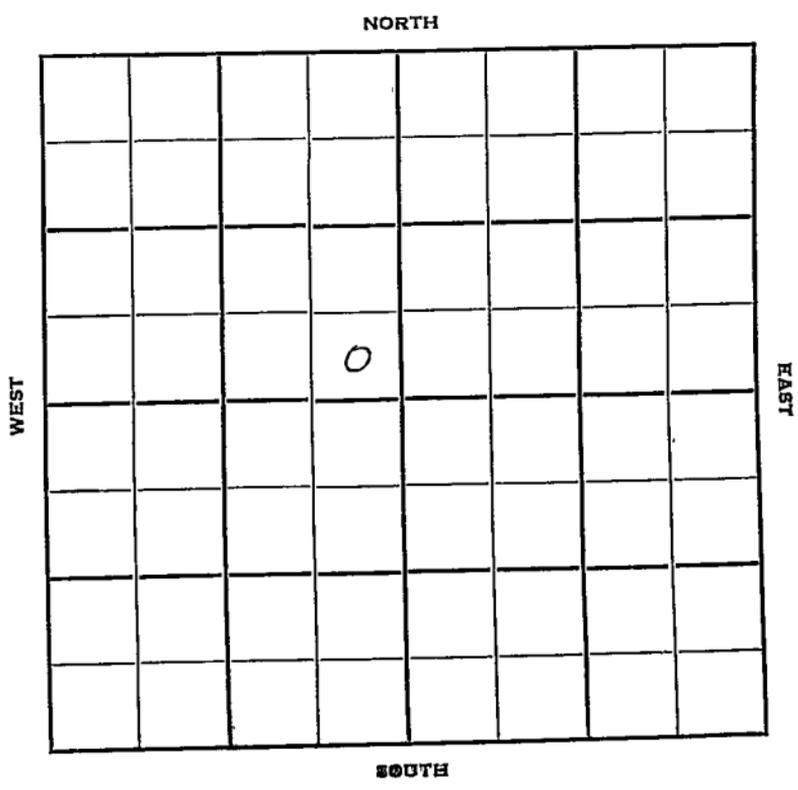

Sec. 35 Twp. 17 R. 11-W

Well No. #1 J Moran Farm

Honaker & R J Shields Company

Bloomer Contractor


_____ Ft. from N. Line

330 Ft. from S. Line

330 Ft. from E. Line

_____ Ft. from W. Line

SE SE NW

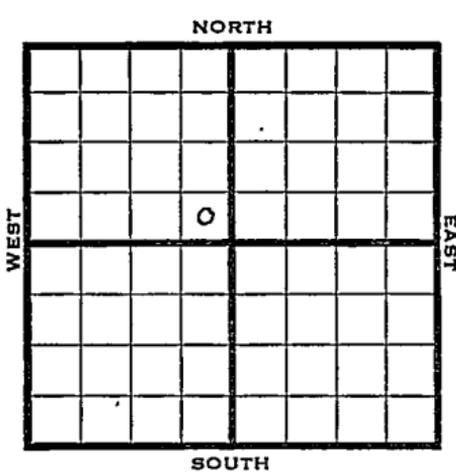

1950 Elev 1824

REPORT

8/30 Spud 8-23-50
8 5/8" @ 207
Anhy 600
drlg 2688

9/6 TD 3335
8 5/8" @ 207
Anhy 600
Arb 3310
D&A

Lans 3012

ABANDONED


County Barton State Kansas

Sec. 35 (Blk. 17) (Sur. 11W) (Twp.) (Rge.) Map No.

Operator Honaker & R. J. Shields

Well No. 1 Farm J. Moran

Elev. 1824 Location SE SE NW

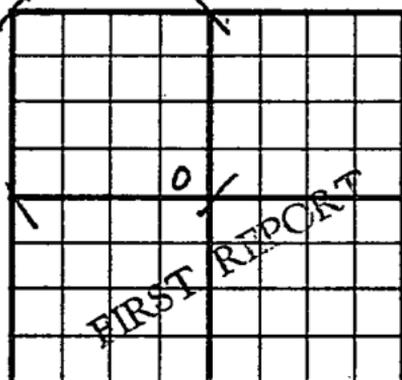

330 Ft. From S Line NW

330 Ft. From E Line Quarter

1st. Report AUG 30 1950

Completion

Remarks

Spudding Date 8-23-50

Drig. Data Bloomer Pool

8 5/8" @ 207 Anhy 600 drig. 2688

J. E. TYRA

County Barton State Kansas

Sec. 35 (Blk. 17) (Sur. 11W) (Twp.) Map No.

Operator Honaker & R. J. Shields

Well No. 1 Farm J. Moran

Elev. 1824 Location SE SE NW

ABANDONED

330 Ft. From S Line NW

330 Ft. From E Line Quarter

Ist. Report

Completion SEP 6 1950

Remarks

Bloomer Pool

Spudding Date 8-23-50

Drlg. Data D & A TD 3335

8 5/8" @ 207 Anyh 600 Lans. 3012

Arb. 3310 TD 3335 D & A

J. E. TYRA