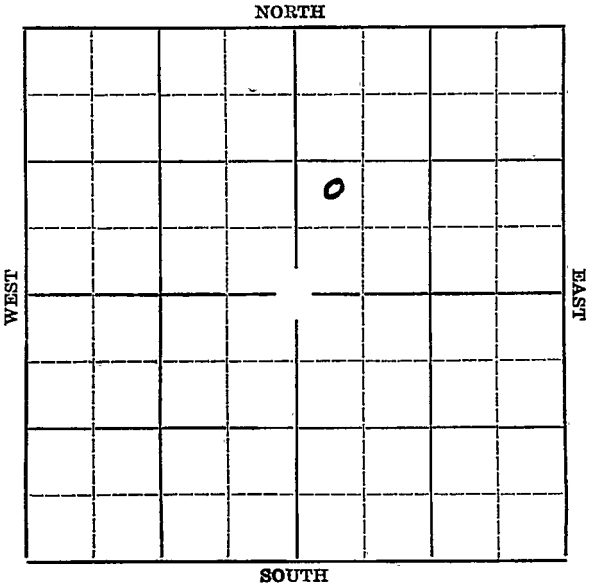


Section 36 Township 17 Range 11-WWell Number #1-BloomerCompany Skelly Oil

Map No. **KANSAS** Sec. **36** Twp. **17** R. **11W**

Well No. **#1 Bloomer** Farm

Skelly Oil Company


Ft. from N. Line

990' Ft. from S. Line

Ft. from E. Line

330' Ft. from W. Line

Elev. 1821

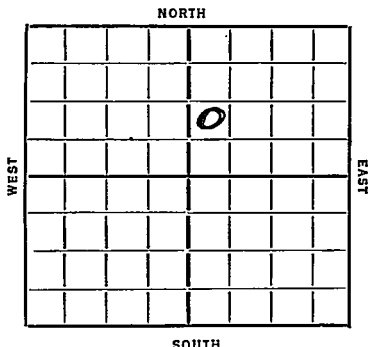

Date	REPORT
1936	
7/29	Building rig.
8/6	12" @ 192'. Waiting on cement.
8/13	776 bbls x oil natural x 2000 x gals x
	x 2000 x gals x
	Drlg. 1820'.
8/20	Drlg. 2950' /
8/27	Siliceous 3266'. 7" @ 3267'. WOC.
9/2/36	-Sil. 3266'.
	T.D. 3270'.
	Pump 2297-bbls natural.

COMPLETED

Map No. 55 Sec. 36 Twp. 17 R. 11W

Well No. 1 Blossum

Spelly Oil Company

Contractor

SECTION PLAT

		0	

_____ Ft. from N. Line

990 Ft. from S. Line

_____ Ft. from E. Line

230 Ft. from W. Line

FIRST REPORT

Location _____

Rig up _____

Drilling and Remarks:

Building rig

RECORD

Cased _____ in., _____ ft.

Sand _____

Gas _____

Oil _____

Total Depth _____

PRODUCTION

1st 24 hrs. Nat. _____

1st 24 hrs. after shot _____

Gas _____ Cu. Ft.

Dry Hole _____

Abandoned _____

Date

JUL 29 1936₁₉

S. J. LEWIS Scout

KANSAS

Map No. 53 Sec. 36 Twp. 17 R. 11WWell No. 1 Bloomer

Company

Contractor

SECTION PLAT

		0	

 Ft. from N. Line790 Ft. from S. Line Ft. from E. Line830 Ft. from W. Line

COMPLETE

Location Rig up

Drilling and Remarks:

Oil 32662297 H&Vadpump

RECORD

Cased in., ft.Sand Gas Oil Total Depth 3270

PRODUCTION

1st 24 hrs. Nat. 1st 24 hrs. after shot Gas Cu. Ft.Dry Hole Abandoned

Date

SEP 2 1936 19

S. J. LEWIS Scout