


Section 36 Township 17 Range 11-W

Well Number 1 Patzner

Company Spencer, Yarnell et al

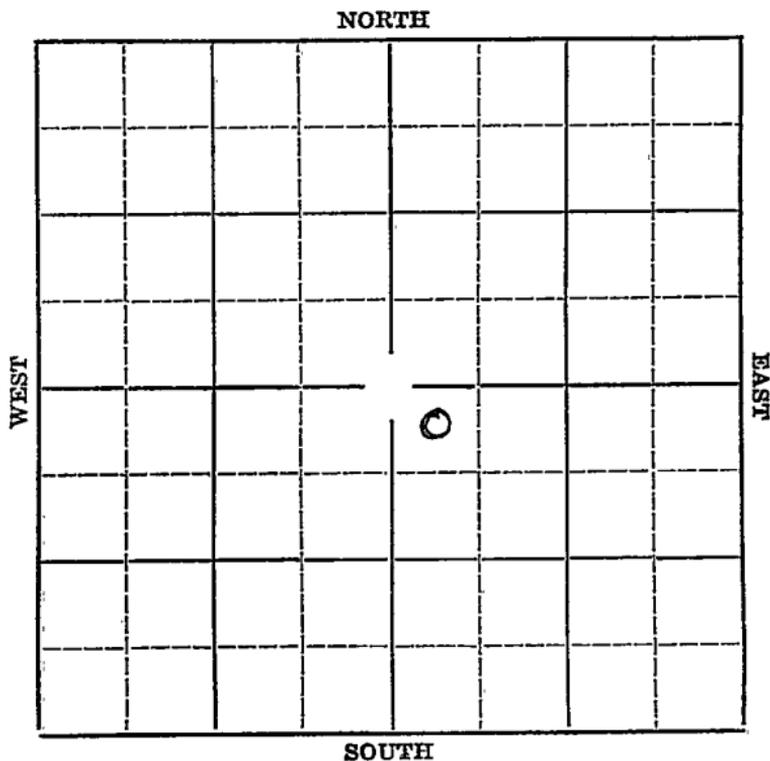

Sec. 36 Twp. 17 R. 11-W

Well No. #1 Patzner Farm


Spencer, Yarnell et al Company

330 Ft. from N. Line

_____ Ft. from S. Line

_____ Ft. from E. Line

330 Ft. from W. Line

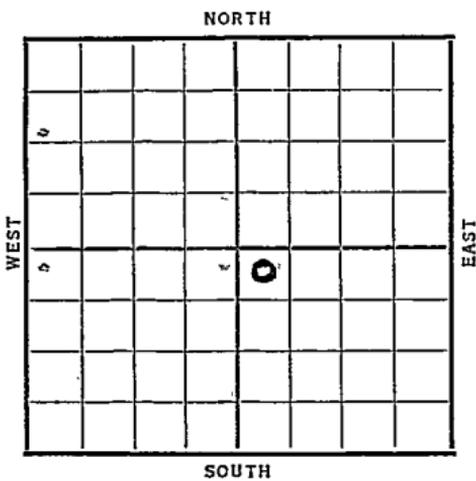

Elev. 1814

Date	REPORT
1937	
3/10	Location
3/18	" "
3/25	"
4/2	" "
4/8	" "
4/16	" "
4/23	" "
4/30	Moving in tools.
5/7	" " "
5/14	Spud
5/21	15" @ 65'. 12" @ 227'.
	Anhy 578'. Drlg. 1465'.
5/28	10" @ 1888'. 8" @ 2240'.
	Drlg. 2340'.
6/4	K.C. 2960-70' S.O.
	6" @ 3100'. C.O.
6/11	6" @ 3248' & Sil.
	T.D. 3250'. H.F.O. --30 Min.
	OVER

1937

6/16 6" @ 3248'.

Sil. 3248'.

T.D. 3250'.

Pump 1577 bbls. 12 hrs.

Pot. 3154 bbls. Nat.

COMPLETED

Map No. 55 Sec. 36 Twp. 17 R. 11W

Well No. 1 Patner

Spencer, Jarnall & Co Company
Contractor

SECTION PLAT

		0	

330 Ft. from N. Line

330 Ft. from S. Line

_____ Ft. from E. Line

330 Ft. from W. Line

FIRST REPORT

Location ✓

Rig up _____

Drilling and Remarks:

RECORD

Cased _____ in., _____ ft.

Sand _____

Gas _____

Oil _____

Total Depth _____

PRODUCTION

1st 24 hrs. Nat. _____

1st 24 hrs. after shot _____

Gas _____ Cu. Ft.

Dry Hole _____

Abandoned _____

Date

MAR 10 1937 19

S. J. LEWIS

Scout

Barton

KANSAS

Map No. 55 Sec. 36 Twp. 17 R. 11 W


Well No. 1 - Patzner "A"

Spencer & Yamell Company
Contractor

COMPLETED

SECTION PLAT

330 Ft. from N. Line
_____ Ft. from S. Line
_____ Ft. from E. Line
330 Ft. from W. Line

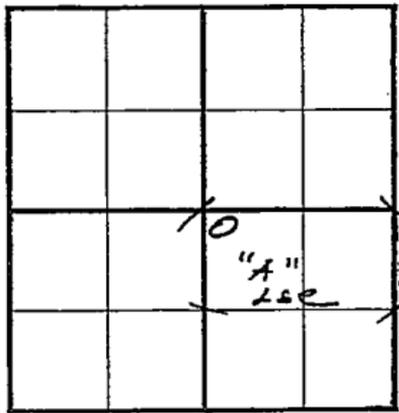

Location _____

Rig up _____

Drilling and Remarks:

Pump 1577/12

Pat - 3154
net

RECORD

Cased 6 in. 3248 ft.

Sand 511 3248

Gas _____

Oil _____

Total Depth 3250

PRODUCTION

1st 24 hrs. Nat. _____

1st 24 hrs. after shot _____

Gas _____ Cu. Ft.

Dry Hole _____

Abandoned _____

Date

JUN 16 1937 19

H. D. Hatfield Scout