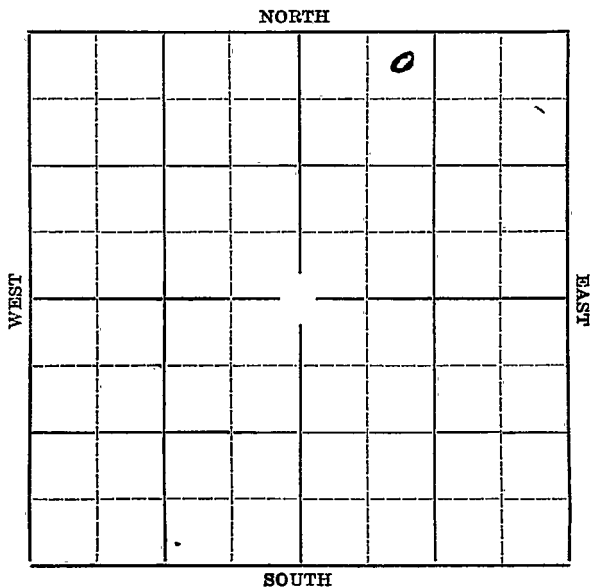


Section 36 Township 17 Range 11-WWell Number #2 BloomerCompany Texas

Map No. KANSAS Sec. 36 Twp. 17 R. 11WWell No. #2 Bloomer FarmTexas

Company

330' Ft. from N. Line Ft. from S. Line Ft. from E. Line990' Ft. from W. Line

Elev. 1817

NORTH

WEST

EAST

SOUTH

~~1936~~
1936

REPORT

7/8 Rig.
7/16 10" @ 173'. Waiting on cement.
7/23 Drlg. 1816'.
7/30 Drlg. 2875'.
8/6 Siliceous 3260'. Set 7".
8/13 Riggig up standard tools.
8/20 TD 3266' hole full of oil.
8/27 Pumped 2026 bbls of oil in 2hrs.
Natural.
9/2/36-Sil. 3260'.
T.D. 3266'.
Pump 2598 bbls of oil natural.

COMPLETED

Map No. 53 Sec. 36 Twp. 17 R. 11WWell No. 2. BloomerHexas Company

Contractor

SECTION PLAT

330 Ft. from N. Line

_____ Ft. from S. Line

_____ Ft. from E. Line

990 Ft. from W. Line

FIRST REPORT

Location _____

Rig up _____

Drilling and Remarks:

Rig

RECORD

Cased _____ in., _____ ft.

Sand _____

Gas _____

Oil _____

Total Depth _____

PRODUCTION

1st 24 hrs. Nat. _____

1st 24 hrs. after shot _____

Gas _____ Cu. Ft.

Dry Hole _____

Abandoned _____

Date

JUL 8 1936 19

S. J. LEWIS

Scout

KANSAS

Map No. 55 Sec. 36 Twp. 17 R. 11WWell No. 2 BloomerJ. E. Jones Company

Contractor

SECTION PLAT

		0	

320 Ft. from N. Line

_____ Ft. from S. Line

_____ Ft. from E. Line

990 Ft. from W. Line

COMPLETE

Location _____

Rig up _____

Drilling and Remarks:

Oil 3260Pump 2598
Nat.

RECORD

Cased _____ in., _____ ft.

Sand _____

Gas _____

Oil _____

Total Depth 3266

PRODUCTION

1st 24 hrs. Nat. _____

1st 24 hrs. after shot _____

Gas _____ Cu. Ft.

Dry Hole _____

Abandoned _____

Date

SEP 2 1936 19

S. J. LEWIS
Scout