


Section 26 Township 30 Range 4E

Well No. 6 Setzkorn

Company Adair Oil

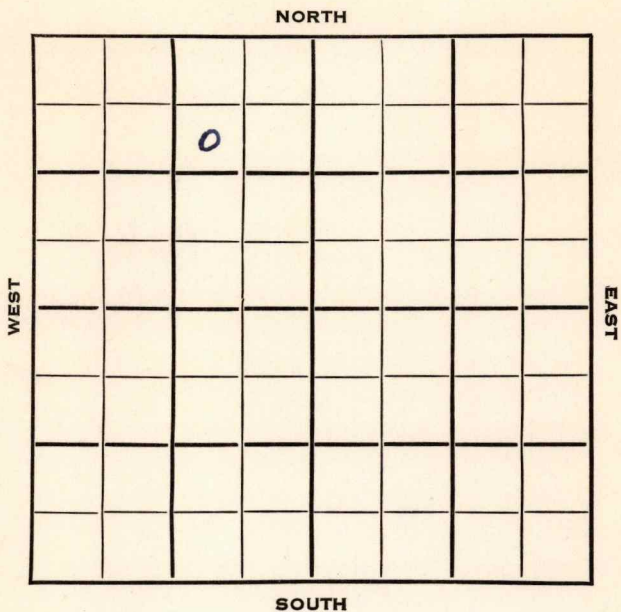

Cowley

KANSAS

SEC.	TWP.	R.
26	30	4 E ✓

WELL NO.

6 Setzkorn

FARM

COMPANY

Adair Oil

CONTRACTOR

Adair Oil

David Pool


990 _____ Ft. from N. Line

_____ Ft. from S. Line

990 _____ Ft. from E. Line

_____ Ft. from W. Line

SW NE NW

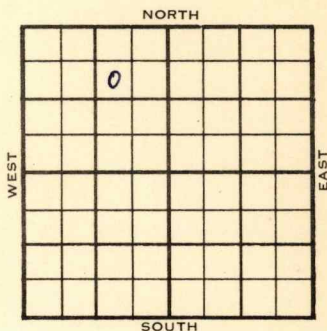

ELEVATION	REPORT
1954	1274'

3/10

MIR

4/21

Spud 3-9-54

D & A

TD 2934'

8" @ 64'

KC 2295', Bart 2929',

TD 2931'

5" @ 2929'

Miss 2933'

DD 2934' PB 2932'

wtr. CO to 2931' wtr.

Perf 2917/ 19

frac. 8 gwph

D & A

ABANDONED

