

KANSAS

Map No. _____ Sec. 7 Twp. 33 R. 3E


Well No. 2 - S. Thurlow Farm
Barnsdall Oil Company

_____ Ft. from N. Line

1115 Ft. from S. Line

990 Ft. from E. Line

_____ Ft. from W. Line

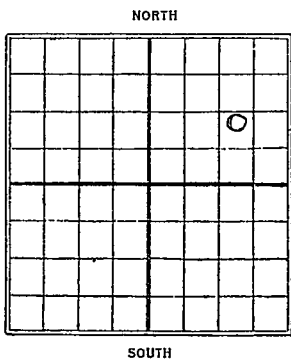

1928

Date	REPORT <u>1126</u>
<u>3/28</u>	<u>Location</u>
<u>4/4</u>	<u>Bldg rig</u>
<u>4/11</u>	<u>Rig</u>
<u>4/18</u>	_____
<u>4/25</u>	_____
<u>5/2</u>	<u>Spud</u>
<u>5/9</u>	<u>Drly 300.</u>
<u>5/16</u>	<u>" 925</u>
<u>5/23</u>	<u>" 1560</u>
<u>5/31</u>	<u>" 1750</u>
<u>6/6</u>	<u>" 1910 - 10" @ 1910.</u>
<u>6/13</u>	<u>" 2280</u>
<u>6/20</u>	<u>T.D. 2280 - S.D. high water</u>
<u>6/27</u>	_____
<u>7/3</u>	<u>Drly 3055</u>
<u>7/11</u>	<u>" 3300</u>
<u>7/18</u>	<u>Top line 3171 - 3380 base - Wileox 3487 - 91 - Sil. line 3491 oil 3492 - T.D. 3500 - shot 10 qts 1300' oil in hole -</u>
<u>7/25</u>	<u>Making 140 bbls oil - + 30 bbls water. (over)</u>

8/1 - Top Sel. line 3491
T. D. 3500 shot 10 gts
140 bbls oil
20 bbls water
Pumping

Map No. KANSAS Sec. 7 Twp. 33 R. 3E

Well No. 2 S. Thurston

Barnsoll Oil Company

Contractor

SECTION PLAT

----- Ft. from N. Line

1115 Ft. from S. Line

990 Ft. from E. Line

----- Ft. from W. Line

			0

FIRST REPORTS

Location ✓

Rig up -----

Drilling and Remarks:

RECORD

Cased ----- in., ----- ft.

Sand -----

Gas -----

Oil -----

Total Depth -----

PRODUCTION

1st 24 hrs. Nat. -----

1st 24 hrs. after shot -----

Gas ----- Cu. Ft.

Dry Hole -----

Abandoned -----

Date

MAR 28 1928

S. J. LEWIS

Map No. **KANSAS** Sec. 7 Twp. 33 R. 37

Well No. 2 S. Thurlow

Barnsdall Oil Company

Contractor

SECTION PLAT

			0

-----Ft. from N. Line

1115 Ft. from S. Line

990 Ft. from E. Line

-----Ft. from W. Line

COMPLETED

Location -----

Rig up -----

Drilling and Remarks:

*Top Oil. Line
3491*





Pumping

RECORD

Cased ----- in., ----- ft.

Sand -----

Gas -----

Oil -----

Total Depth -----

PRODUCTION

1st 24 hrs. Nat. -----

1st 24 hrs. after shot -----

Gas ----- Cu. Ft.

Dry Hole -----

Abandoned -----

Date

AUG 1 1928

192

S. J. LEWIS

Scout