

Cowley

KANSAS

SECTION 27 TOWNSHIP 30 RANGE 4 E

WELL NO. #1 Floyd

COMPANY Hittle

NORTH

							0

WEST

EAST

SOUTH

Cowley

KANSAS

SEC. 27	TWP. 30	R. 4E
------------	------------	----------

WELL NO. #1 Floyd FARM

COMPANY Hittle

CONTRACTOR Wakefield


_____ Ft. from N. Line

_____ Ft. from S. Line

_____ Ft. from E. Line

_____ Ft. from W. Line

SE SE NE

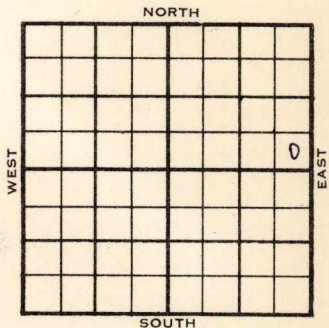

1955	ELEVATION	REPORT
------	-----------	--------

12-28 Location

1956

1-5 Comm. 12-26-55
D&A
M. 2943'
TD 2960'

ABANDONED

County Cowley Elev. _____
 Sec. 27 Twp. 30 Rge. 4E
 Company Hittle
 Farm Name Floyd No. 1

TOPS	DEPTH	LOG	DATUM
Anh.			
Tp.			
H.			
Tr.			
Dg.			
Bl.			
L.			
K.C.			
B.K.C.			
Ce.			
C.			
M.			
M.			
K.			
Mz.			
Me.			
V.			
S.			
S.			
A			
R.			
Pe.			
G.			
T.D.			

Loc. in Sec. SE SE NE
 Geol. _____
 Contr. Wakofield
 Pool _____

FIRST REPORT
 DEC 23 '55

Date Comm. _____
 Location _____

Co.
Lse.
No.
Sec.
T.
R.

County Cowley Elev. _____
 Sec. 27 Twp. 30 Rgs. 4E
 Company Hittle
 Farm Name Floyd No. 1

TOPS	DEPTH	LOG	DATUM	Loc. in Sec.
Anh.				SE SE NE
Tr.				
Dg.				
Bl.				
L.				Geol. _____
K.C.				Contr. _____
B.K.C.				Wakefield
Ce.				Pool
C.				
M.	2943			
M.				
K.				
Mz.				
Mq.				
V.				
S.				
S.				
A.				
R.				
PE.				
G.				
T.D.	2960			



Date Comm. 12-26-55 JAN 5 1956

D & A

Co.
 Use.
 No.
 Sec.
 T.
 R.