


Section 8 Township 33 Range 3E

Well No. #4 Hilzfinger

Company Martin Wunderlick

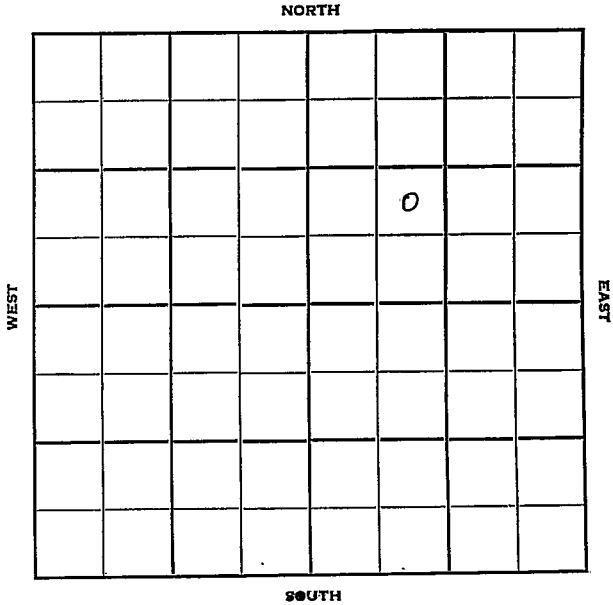

Sec. 8 Twp. 33 R. 3 E

Well No. # 4 Hillfinger Farm

Martin Wunderlick Company

Watson Contractor

Thurlow Pool


..... Ft. from N. Line

890 Ft. from S. Line

..... Ft. from E. Line

990 Ft. from W. Line

NE SW NE

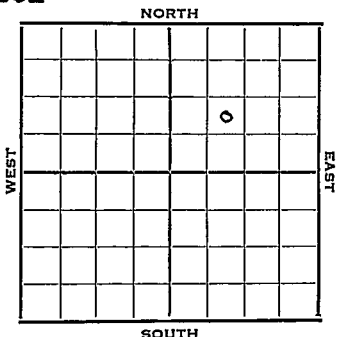

1951 Elev. 1126' REPORT

11/21 Spud 11-17-51  
8" @ 85  
Drlg. 1410'

12/19 Spud 11-17-51  
Oil well TD 3495½' 8" @ 85  
Layton 2525' -KC 2712' Miss 3155'  
Chattanooga 3416' Simp. 3486'  
Arb. 3495'  
5" @ 3495 TD 3495½'  
Comp. 35 BOPD

**COMPLETED**



County Cowley State Kansas

Sec. 8 (Blk. 33) (Sur. Rge.) 3E Map No.

Operator Martin Wunderlick

Well No. 4 Farm Hillfinger

Elev. 1126 Location NE SW NE


890 Ft. From S Line NE

990 Ft. From W Line Quarter

Ist. Report

Completion DEC 19 1951

Remarks Thurlow Pool

Watson - Contr.

Spudding Date 11-17-51

Drilg. Data Oil well TD 3495 $\frac{1}{2}$

8" @ 85 Layton 2525 KC 2712

Miss. 3155 Chattanooga 3416 Simp. 3486

Arb. 3495 5" @ 3495 TD 3495 $\frac{1}{2}$

Comp. 35 bopd

J. E. TYRA