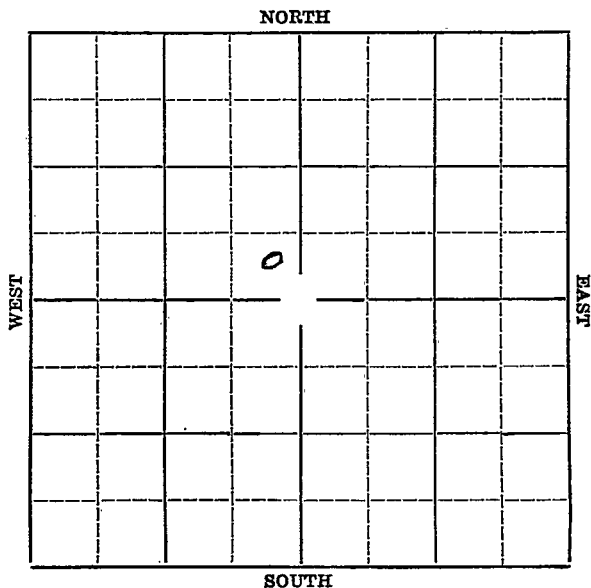
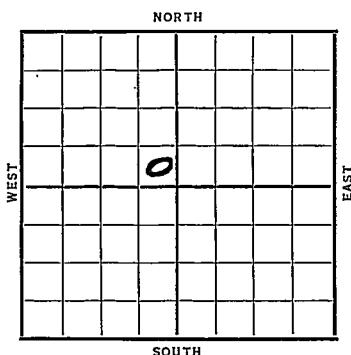


Section 36 Township 17 Range 11-WWell Number #3-BloomerCompany Republic O & G

Sec. 36 Twp. 17 R. 11WWell No. #3 Bloomer FarmRepublic O & G Company Ft. from N. Line330' Ft. from S. Line330' Ft. from E. Line Ft. from W. Line

Elev. 1817

~~1936~~

REPORT

9/9

Rig.

9/18

Rigging up.

9/24

10" @ 181'. Drlg. 1800'.

10/1

Siliceous 3269'. 6" @ 3270'. CO.

10/8

T.D. 3279½'. Pump 50 bbls of
oil per hour.

10/14/36-Sil. 3269'.

T.D. 3279½'.

Potential 1732 bbls natural.

COMPLETED

Map No. 55 Sec. 36 Twp. 17 R. 11WWell No. 3 Bloomer.Republic Oil & G. Company

Contractor

SECTION PLAT

_____ Ft. from N. Line

330 Ft. from S. Line330 Ft. from E. Line

_____ Ft. from W. Line

FIRST REPORT

Location _____

Rig up _____

Drilling and Remarks:

Rig

RECORD

Cased _____ in., _____ ft.

Sand _____

Gas _____

Oil _____

Total Depth _____

PRODUCTION

1st 24 hrs. Nat. _____

1st 24 hrs. after shot _____

Gas _____ Cu. Ft.

Dry Hole _____

Abandoned _____

Date

SEP 9 1936₁₉

Scout

Barton
 Map No. 55 Sec. 26 Twp. 17 R. 11W

Well No. 3 Bloomer

Republic Oil & Gas Company

Contractor

SECTION PLAT

_____ Ft. from N. Line

230 Ft. from S. Line

330 Ft. from E. Line

_____ Ft. from W. Line

COMPLETED

Location _____

Rig up _____

Drilling and Remarks:

Oil 3269

Per 1732

Nat.

RECORD

Cased _____ in., _____ ft.

Sand _____

Gas _____

Oil _____

Total Depth 3279 1/2

PRODUCTION

1st 24 hrs. Nat. _____

1st 24 hrs. after shot _____

Gas _____ Cu. Ft.

Dry Hole _____

Abandoned _____

Date

OCT 14 1936

19

S. J. LEWIS Scout