

Section 8 Township 33 Range 3E

Well No. #3 Hilfinger

Company Martin Wanderlich

NORTH

				0					

SOUTH

WEST

EAST

Cowley

KANSAS

Sec. 8 Twp. 33 R. 3E

Well No. #3 Hilfinger Farm

Martin Wanderlich Company

Watson Contractor

Thurlow


_____ Ft. from N. Line

990 Ft. from S. Line

_____ Ft. from E. Line

330 Ft. from W. Line

NW SW NE

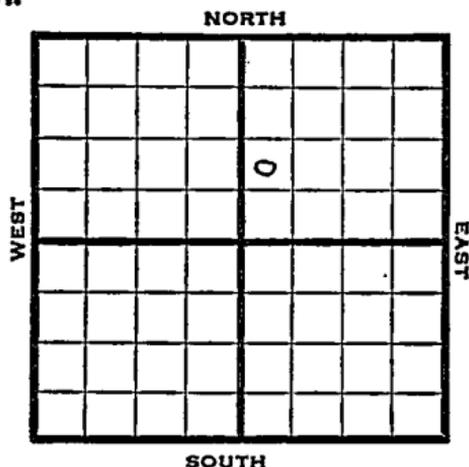

1951

Elev. 1127' REPORT

10/31

RUR

12/12

Oil Well TD 3497
 8" @ 1200 KC 2709 Miss. 3154
 Stal. 2150 TD 3483
 5" @ 3481 Simp. 3483-93 SSO
 Arb. 3493-95 TD
 Hydro. Simp. HFW DD 3497 150A
 S/ 3 BO 2 BW 6 hr.
 Comp. 80 BO 60 BWPD

COMPLETED

County **Cowley** State **Kansas**

Sec. **8** (Blk. Twp.) **33** (Sur. Rge.) **3R** Map No.

Operator **Martin Wanderlich**

Well No. **3** Farm **Hilfinger**

Elev. Location **NW SW NE**

990 Ft. From **S** Line **NE**

330 Ft. From **W** Line Quarter

Ist. Report **OCT 31 1951**

Completion

Remarks

Watson - Contr.

Spudding Date

Drlg. Data **Thurlow**

RUR

J. E. TYRA

