


Map No. 15 Sec. 16 Twp. 30 R. 4<sup>E</sup>

Well No. 1 Starkey Farm  
C. E. Ash Company

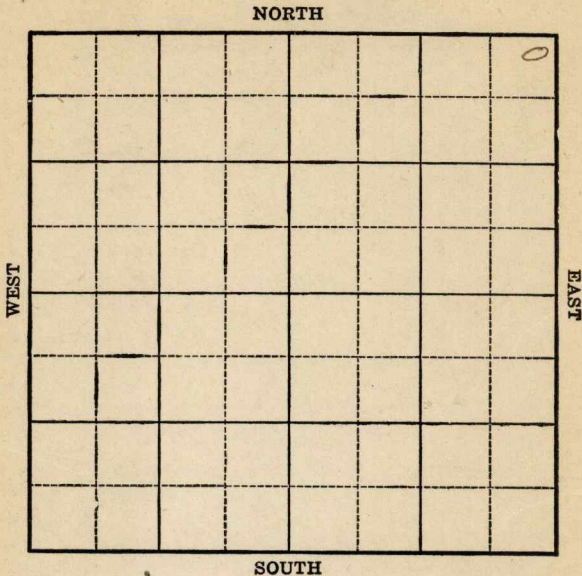

Location \_\_\_\_\_

Drilling Remarks:

\_\_\_\_\_

\_\_\_\_\_

**RECORD**

Cased \_\_\_\_\_ in. \_\_\_\_\_ ft.

Sand \_\_\_\_\_

Gas \_\_\_\_\_

Oil \_\_\_\_\_

Total Depth \_\_\_\_\_

Rig Up \_\_\_\_\_

Drilling Remarks:

\_\_\_\_\_

\_\_\_\_\_

**PRODUCTION**

1st 24 hrs. Nat. \_\_\_\_\_

1st 24 hrs. after shot \_\_\_\_\_

Gas \_\_\_\_\_ cu. ft.

Dry Hole \_\_\_\_\_

Abandoned \_\_\_\_\_

Map No. K Sec. 16 Twp. 30 R. 4<sup>E</sup>


Well No. 1 Starkey Farm  
C. E. Ash Company

200 Ft. from N. Line

\_\_\_\_\_ Ft. from S. Line

200 Ft. from E. Line

\_\_\_\_\_ Ft. from W. Line

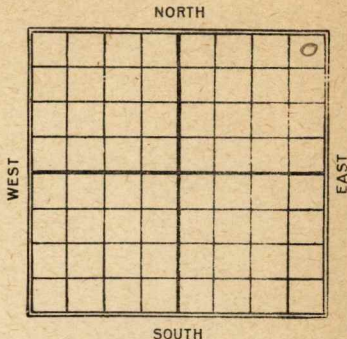

Date	REPORT
1924	
11/6	Rain up
11/26	Dly @ 2120'
12/17	Dly @ 2870'
1925	
1/21	Wilcox Sand 3307-16 H.F.W
	S. + G. 3316'

Map No. 11 KANSAS Sec. 16 Twp. 30 R. 4E

Well No. 1 Starkey

G. E. Ash Company

Contractor

**FIRST REPORT**

**SECTION PLAT**

200 Ft. from N. Line

----- Ft. from S. Line

200 Ft. from E. Line

----- Ft. from W. Line

			0

Location -----

Rig up -----

Drilling and Remarks:

*Rig up*

**RECORD**

Cased ----- in., ----- ft.

Sand -----

Gas -----

Oil -----

Total Depth -----

**PRODUCTION**

1st 24 hrs. Nat. -----

1st 24 hrs. after shot -----

Gas ----- Cu. Ft.

Dry Hole -----

Abandoned -----

Date

NOV 6 1924

192

M. A. BENEAR

Scout

**KANSAS**

Map No. \_\_\_\_\_ Sec. 16 Twp. 30 R. 4E

Well No. 1 Starkey

C. E. Ash et al Company

Contractor \_\_\_\_\_

# ABANDONED SECTION PLAT

200 Ft. from N. Line

\_\_\_\_\_ Ft. from S. Line

200 Ft. from E. Line

\_\_\_\_\_ Ft. from W. Line

			0

Location \_\_\_\_\_

Rig up \_\_\_\_\_

Drilling and Remarks:

Wilcox 3307-16

H.F.W.

1049

3316'

### RECORD

Cased \_\_\_\_\_ in., \_\_\_\_\_ ft.

Sand \_\_\_\_\_

Gas \_\_\_\_\_

Oil \_\_\_\_\_

Total Depth \_\_\_\_\_

### PRODUCTION

1st 24 hrs. Nat. \_\_\_\_\_

1st 24 hrs. after shot \_\_\_\_\_

Gas \_\_\_\_\_ Cu. Ft.

Dry Hole \_\_\_\_\_

Abandoned \_\_\_\_\_

Date

4/21

1925

**M. A. BENEAR**

Scout

MAP No. K11 **KANSAS** SEC. 16 TWP. 30S R. 4E

WELL No. 1 Starkey  
dash shaft

COMPANY

CONTRACTOR

SECTION PLAT

**ABANDONED**

			e

\_\_\_\_\_ FT. FROM N. LINE

\_\_\_\_\_ FT. FROM S. LINE

\_\_\_\_\_ FT. FROM E. LINE

\_\_\_\_\_ FT. FROM W. LINE

LOCATION \_\_\_\_\_

RIG UP \_\_\_\_\_

DRILLING AND REMARKS:

RECORD

CASED \_\_\_\_\_ IN., \_\_\_\_\_ FT.

SAND \_\_\_\_\_

GAS \_\_\_\_\_

OIL \_\_\_\_\_

TOTAL DEPTH 3316

PRODUCTION

1ST 24 HRS. NAT. \_\_\_\_\_

1ST 24 HRS. AFTER SHOT \_\_\_\_\_

GAS \_\_\_\_\_ CU. FT.

DRY HOLE ✓

ABANDONED \_\_\_\_\_

DATE

1/23 192 5

SCOUT