

# KANSAS

Cowley

Section 8 Township 33 Range 3-E

Well No. #3 Jennings

Company Watson Drlg  
Miscellaneous

NORTH

		0					

WEST

EAST

SOUTH

KANSAS

Cowley

Sec. 8 Twp. 33 R. 3E

Well No. 3 Jennings Farm


Watson Drlg. Company  
Pool Misc. Contr-Watson

         Ft. from N. Line

330 Ft. from S. Line

990 Ft. from E. Line

         Ft. from W. Line

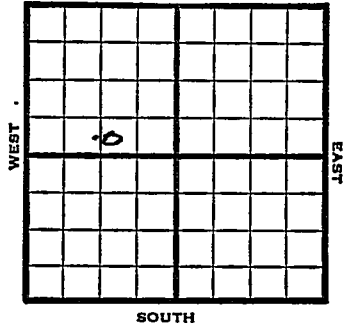

SW SE NW

1949

Elev 1125' REPORT

8/24

8" @ 116'  
Drlg. 725'

8/31

Drlg 2540'

9/7

Miss 2155'  
Drlg. 2395'

9/14

Arb. 3486'-88'  
TD 3488

5" @ 3486

500 acid

9/21

TD 3488'-  
Arb. 3486'

5 @ 3486'

500 acid

Pump 50 Oil / 10 W

38° Gr.

Comp

**COMPLETED**

Map No. \_\_\_\_\_ Sec. 8 Twp. 33 R. 3E

Well No. 3 Jennings

Watson Drlg. \_\_\_\_\_ Company

Watson \_\_\_\_\_ Contractor

SW SE NW

~~FIRST REPORT~~  
SECTION PLAT

\_\_\_\_\_ Ft. from N. Line

330 Ft. from S. Line

990 Ft. from E. Line

\_\_\_\_\_ Ft. from W. Line


Cowley County

Location \_\_\_\_\_

Rig up \_\_\_\_\_

Drilling and Remarks:

8" @ 116

drlg. 725

RECORD

Cased \_\_\_\_\_ in., \_\_\_\_\_ ft.

Sand \_\_\_\_\_

Gas \_\_\_\_\_

Oil \_\_\_\_\_

Total Depth \_\_\_\_\_

PRODUCTION

1st 24 hrs. Nat. \_\_\_\_\_

1st 24 hrs. after shot \_\_\_\_\_

Gas \_\_\_\_\_ Cu. Ft.

Dry Hole \_\_\_\_\_

Abandoned \_\_\_\_\_

Date

AUG 24 1949 19

S. J. LEWIS

Scout

Map No. K1 Sec. 8 Twp. 33 R. 3E


Well No. 3 Jennings

Watson Drlg. Company

**COMPLETE** Contractor

SW SE NW E 1, 1125  
**SECTION FLAT**

         Ft. from N. Line  
330 Ft. from S. Line  
990 Ft. from E. Line  
         Ft. from W. Line

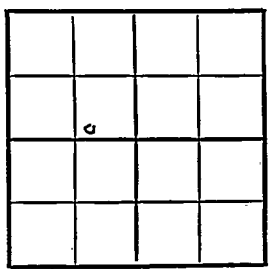

Cowley County

Location                                 

Rig up                                 

Drilling and Remarks:

*Ar 3486*  
*5" @ 3486*  
*5-00 acid*  
*Pump 500 ft 110 W*  
*350 ft*

**RECORD**

Cased          in.,          ft.  
Sand                                   
Gas                                   
Oil                                   
Total Depth 3486

**PRODUCTION**

1st 24 hrs. Nat.                           
1st 24 hrs. after shot                           
Gas                          Cu. Ft.  
Dry Hole                           
Abandoned                         

Date

SEP 21 1949 19 S. J. LEWIS Scout