

Barton


O. W. D. D

KANSAS

Section.....36.....Township.....17.....Range.....11-W

Well Number.....<sup>2</sup>/~~1~~ Gemeinhardt "A"

Company.....Spencer & Yarnett et al

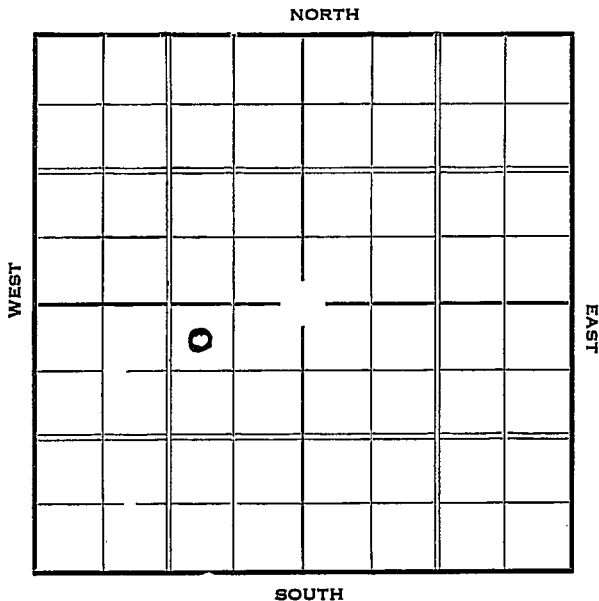



1951

10/31 Lans. 2980' Cong. 3275' Arb. 3280'  
OTD 3316'  
6" @ 3280' was arb. prod.  
5"@ 3375' Regon 3460'  
Drlg. 3565' for Swd.

11/7 SWD well TD 3610  
Lans. 2980 Cong. 3275  
Arb. 3280  
OTD 3316  
6" @ 3280 5" @ 3375  
Regan 3469 Granite wash 3536  
TD 3610 3000 A  
Comp/ for SWD well

**ABANDONED**

**KANSAS**

Map No. 55 Sec. 36 Twp. 17 R. 11W.

Well No. 1 Gemeinhardt

Spencer & Garnett & Co. Company  
Contractor

**SECTION PLAT**

330 Ft. from N. Line

\_\_\_\_\_ Ft. from S. Line

990 Ft. from E. Line

\_\_\_\_\_ Ft. from W. Line

	o		

**FIRST REPORT**

Location \_\_\_\_\_

Rig up \_\_\_\_\_

Drilling and Remarks:

ROG

**RECORD**

Cased \_\_\_\_\_ in., \_\_\_\_\_ ft.

Sand \_\_\_\_\_

Gas \_\_\_\_\_

Oil \_\_\_\_\_

Total Depth \_\_\_\_\_

**PRODUCTION**

1st 24 hrs. Nat. \_\_\_\_\_

1st 24 hrs. after shot \_\_\_\_\_

Gas \_\_\_\_\_ Cu. Ft.

Dry Hole \_\_\_\_\_

Abandoned \_\_\_\_\_

Date

DEC 16 1936 19

S. J. LEWIS Scout

# KANSAS

Map No. 53 Sec. 36 Twp. 17 R. 11W

Well No. 1 Geneinhardt

Spencer & Yarnall et al Company  
Contractor

### SECTION PLAT

330 Ft. from N. Line

\_\_\_\_\_ Ft. from S. Line

990 Ft. from E. Line

\_\_\_\_\_ Ft. from W. Line

	o		

**COMPLETED**

Location \_\_\_\_\_

Rig up \_\_\_\_\_

Drilling and Remarks:

*Sil 3280*  
*1000 acid*  
*Potential*  
*914*

### RECORD

Cased \_\_\_\_\_ in., \_\_\_\_\_ ft.

Sand \_\_\_\_\_

Gas \_\_\_\_\_

Oil \_\_\_\_\_

Total Depth 3316

### PRODUCTION

1st 24 hrs. Nat. \_\_\_\_\_

1st 24 hrs. after shot \_\_\_\_\_

Gas \_\_\_\_\_ Cu. Ft.

Dry Hole \_\_\_\_\_

Abandoned \_\_\_\_\_

Date

**FEB 10 1937**

19

**S. J. LEWIS** Scout

County Barton State Kansas

Sec. 36 (Blk. Twp.) 17 (Sur. Rge.) 11W Map No.

Operator Atlantic

Well No. 2 Farm Gemeinhardt (A)

Elev. 1815 Location NW NE SW


330 Ft. From N Line SW

990 Ft. From E Line Quarter

Ist. Report OCT 31 1951

Completion \_\_\_\_\_

Remarks OWDD

Spudding Date \_\_\_\_\_

Drlg. Data

Lans 2980 Cong 3275 Arb 3280 OTD 3316  
6" @ 3280 was arb. prod. 5" @ 3375 Regon  
3469 Drlg. 3565 for Swd.

J. E. TYRA

County Barton State Kansas

Sec. 36 (Blk. (Twp.) 17) (Sur. Rge.) 11W Map No.

Operator Atlantic

Well No. 2 Farm Bemeinhardt "A"

Elev. 1815 Location NW NE SW


330 Ft. From N Line SW

990 Ft. From E Line Quarter

1st. Report

Completion NOV 7 1951

Remarks OWDD

Spudding Date

**O. W. D. D**

Drig. Data SWD well TD 3610

Lans. 2980 Cong. 3275 Arb. 3280 OTD3316

6" @ 3280 5" @ 3375 Regan 3469

Granite wash 3536 TD 3610 3000 A

Comp. for SWD well