


Section 36 Township 17 Range 11-W

Well Number 2 Patzner

Company Spencer, Yarnell et al

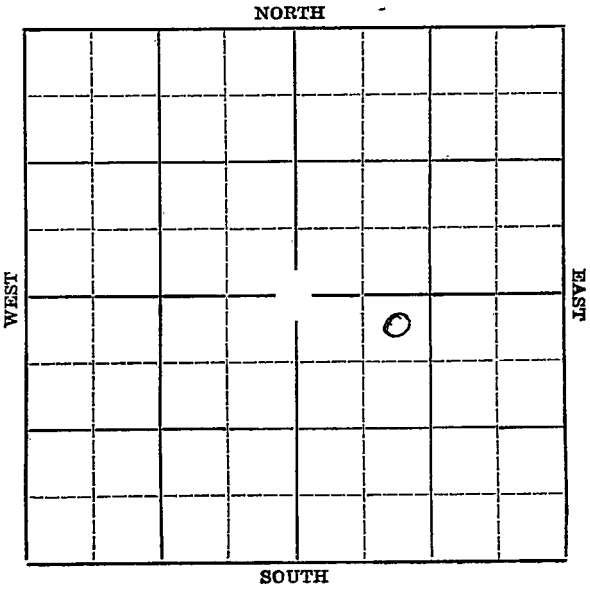

Sec. 36 Twp. 17 R. 11-W

Well No. #2 Patzner Farm

Spencer, Yarnell et al Company


330 Ft. from N. Line

\_\_\_\_\_ Ft. from S. Line

\_\_\_\_\_ Ft. from E. Line

990 Ft. from W. Line

Elev. 1813

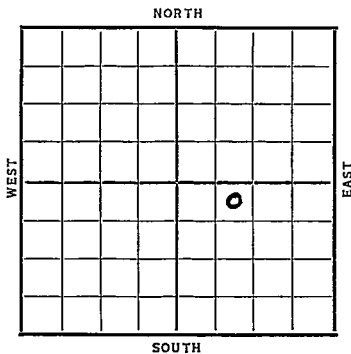

Date	REPORT
1932	
3/10	Cellar
3/18	10" @ 208' Drlg. 250'.
3/25	Drlg. 2080'.
4/2	Drlg. 2850'.
4/8	Sil 3253', 7" @ 3254' WOC
4/14	Sil. 3253'.
	T.D. 3257'.
	Potential 2625 natural.
	<b>COMPLETED</b>



Contractor

### SECTION PLAT

380 Ft. from N. Line  
\_\_\_\_\_ Ft. from S. Line  
\_\_\_\_\_ Ft. from E. Line  
990 Ft. from W. Line

		o	

### FIRST REPORT

Location \_\_\_\_\_

Rig up \_\_\_\_\_

Drilling and Remarks:

*Cellar*

### RECORD

Cased \_\_\_\_\_ in., \_\_\_\_\_ ft.

Sand \_\_\_\_\_

Gas \_\_\_\_\_

Oil \_\_\_\_\_

Total Depth \_\_\_\_\_

### PRODUCTION

1st 24 hrs. Nat. \_\_\_\_\_

1st 24 hrs. after shot \_\_\_\_\_

Gas \_\_\_\_\_ Cu. Ft.

Dry Hole \_\_\_\_\_

Abandoned \_\_\_\_\_

Date

MAR 10 1937 19

S. J. LEWIS

Scout

**KANSAS** *Barton*

Map No. \_\_\_\_\_ Sec. *36* Twp. *17* R. *11W*

Well No. *2 Patzner*

*Spencer & Yarnall* Company  
Contractor

**SECTION PLAT**

*330* Ft. from N. Line  
\_\_\_\_ Ft. from S. Line  
\_\_\_\_ Ft. from E. Line  
*990* Ft. from W. Line

		0	

**COMPLETED**

Location \_\_\_\_\_

Rig up \_\_\_\_\_

Drilling and Remarks:

*Sil 3253*  
*Potential*  
*2625 natural*

**RECORD**

Cased \_\_\_\_\_ in., \_\_\_\_\_ ft.  
Sand \_\_\_\_\_  
Gas \_\_\_\_\_  
Oil \_\_\_\_\_  
Total Depth *3257*

**PRODUCTION**

1st 24 hrs. Nat. \_\_\_\_\_  
1st 24 hrs. after-shot \_\_\_\_\_  
Gas \_\_\_\_\_ Cu. Ft.  
Dry Hole \_\_\_\_\_  
Abandoned \_\_\_\_\_

Date

APR 14 1937 19

S. J. LEWIS Scout