


Section 17 Township 30 Range 4E

Well No. 2 Sims

Company Stelbar Oil

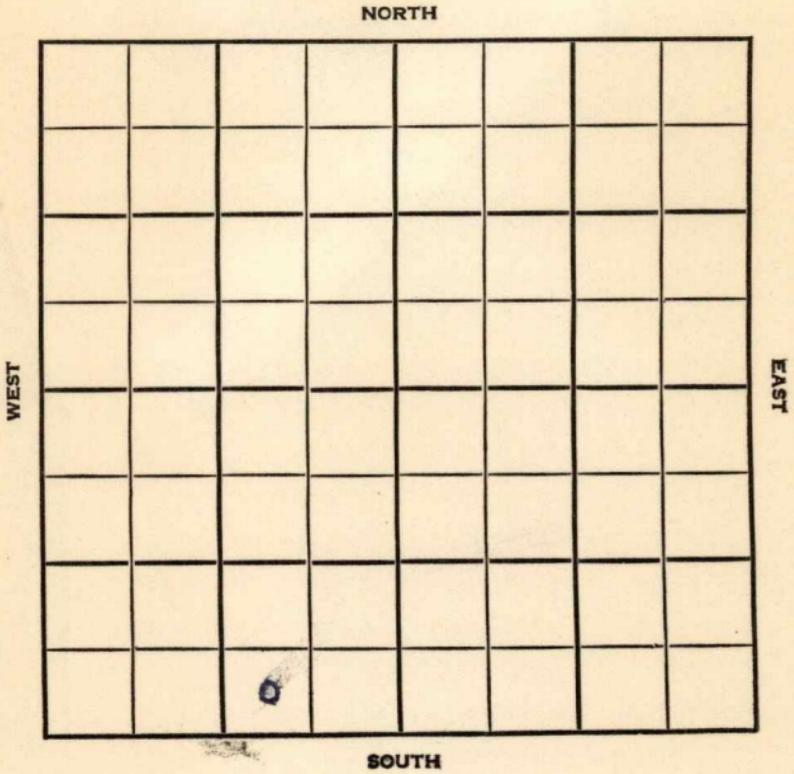

Cowley

KANSAS

SEC.	TWP.	R.
17	30	4E ✓

WELL NO. _____

2 Sims FARM

COMPANY _____

CONTRACTOR _____

Stelbar O₁

Trees Pool

NORTH


_____ Ft. from N. Line

330 _____ Ft. from S. Line

990 _____ Ft. from E. Line

_____ Ft. from W. Line

SW SE SW

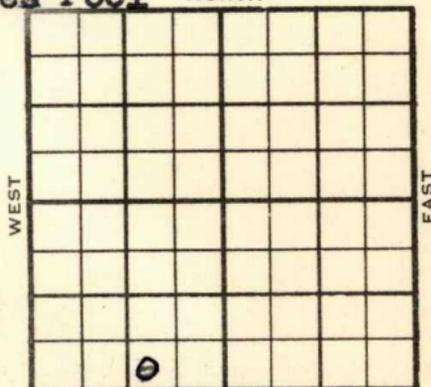

SOUTH

1954

ELEVATION

1161'

REPORT

6/2
6/30

Location

Spud 6-14-54 D & A TD 2905
 8" @ 51 KC 2283 Oswego 2615
 Cherokee 2727 Miss. 2886
 TD 2905 D & A

ABANDONED

