


Barton

Form 51-5M-3-35-Mid-West

Map No. _____ Sec. 36 Twp. 17 R. 11-WWell No. #3-Bloomer Farm _____
Yarnell & Carlson Company

NORTH

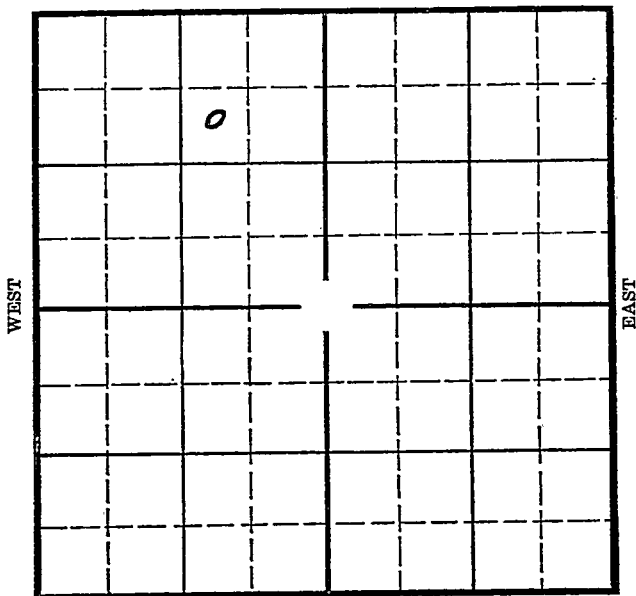

SOUTH

Location _____

Drilling Remarks _____

Rig Up _____

Drilling Remarks _____

RECORD

Cased _____ in. _____ ft.

Sand _____

Gas _____

Oil _____

Total Depth _____

PRODUCTION

1st 24 hrs. Nat. _____

1st 24 hrs. after shot _____

Gas _____ cu. ft. _____

Dry Hole _____


Abandoned _____

Barton

Yarnell & Carlson Company

Ft. from W. Line

Elev. 1823

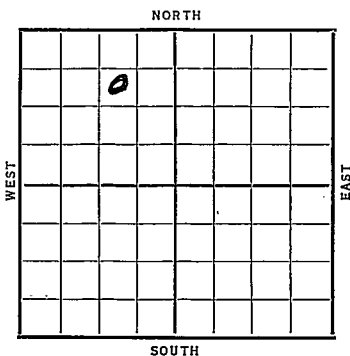[illegible]

KANSAS

Map No. 55 Sec. 26 Twp. 12 R. 11W

Well No. 3 Bloomer

Garnett & Carlson Company

Contractor

SECTION PLAT

	o		

990 Ft. from N. Line

_____ Ft. from S. Line

990 Ft. from E. Line

_____ Ft. from W. Line

FIRST REPORT

Location ✓

Rig up _____

Drilling and Remarks:

RECORD

Cased _____ in., _____ ft.

Sand _____

Gas _____

Oil _____

Total Depth _____

PRODUCTION

1st 24 hrs. Nat. _____

1st 24 hrs. after shot _____

Gas _____ Cu. Ft.

Dry Hole _____

Abandoned _____

Date

SEP 16 1936 19

S. J. LEWIS Scout

KANSAS

Map No. 55 Sec. 36 Twp. 17 R. 11WWell No. 3 BloomerYarnall & Carlson Company
Contractor

SECTION PLAT

	o		

990 Ft. from N. Line

_____ Ft. from S. Line

990 Ft. from E. Line

_____ Ft. from W. Line

COMPLETED

Location _____

Rig up _____

Drilling and Remarks:

Sil 3305
2000 acid
4000 acid
Per 1139

RECORD

Cased _____ in., _____ ft.

Sand _____

Gas _____

Oil _____

Total Depth 3329

PRODUCTION

1st 24 hrs. Nat. _____

1st 24 hrs. after shot 2

Gas _____ Cu. Ft.

Dry Hole _____

Abandoned _____

Date

DEC 2 1936

19

S. J. LEWIS Scout