


Section 36 Township 17 Range 11-W

Well Number #3 Bloomer

Company Texas

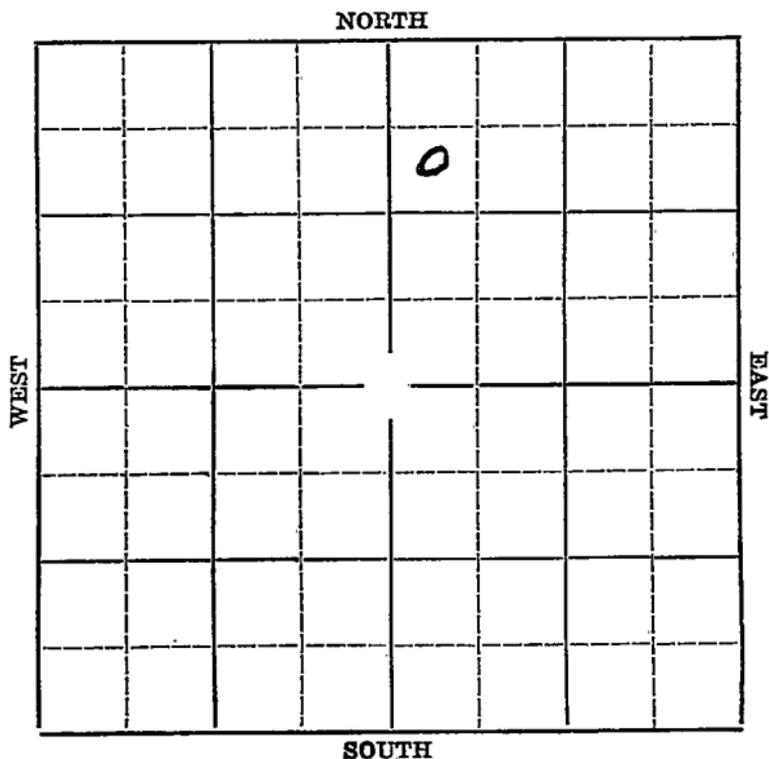

Map No. KANSAS Sec. 36 Twp. 17 R. 11W

Well No. #3 Bloomer Farm

Texas Company. Company


990' Ft. from N. Line

_____ Ft. from S. Line

_____ Ft. from E. Line

330' Ft. from W. Line

Elev. 1824

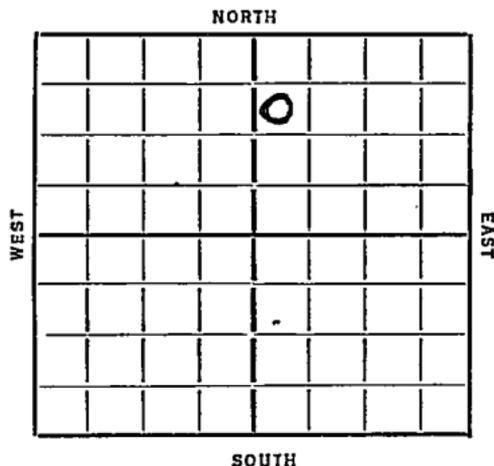

Date	REPORT
1936	
7/15	Rig on ground.
7/23	Building rig.
7/30	--
8/6	10" @ 165'. Drlg. 190'.
8/13	Drlg. 1775'.
8/20	Drlg. 2765'.
8/27	Siliceous ^{3268'} 3273' . 7" @ 3283'. WOC.
9/3	Siliceous 3268'. (Corrected)
	T.D. 3273'. Rigging up st'd tools.
9/9/36	-Sil. 3268'. (CORRECTED)
	T.D. 3273'.
	Potential 2569 bbls natural.
	COMPLETED

Barton

Map No. 55 Sec. 36 Twp. 17 R. 11W

Well No. 3 Blomner

Texas Company

Contractor

SECTION PLAT

		0	

990 Ft. from N. Line

_____ Ft. from S. Line

_____ Ft. from E. Line

380 Ft. from W. Line

FIRST REPORT

Location _____

Rig up _____

Drilling and Remarks:

RCY

RECORD

Cased _____ in. _____ ft.

Sand _____

Gas _____

Oil _____

Total Depth _____

PRODUCTION

1st 24 hrs. Nat. _____

1st 24 hrs. after shot _____

Gas _____ Cu. Ft.

Dry Hole _____

Abandoned _____

Date

JUL 15 1936₁₉

S. J. LEWIS Scout

KANSAS

Map No. 55 Sec. 26 Twp. 17 R. 11W

Well No. 3 Blossmer

Texas Company

Contractor

SECTION PLAT

		a	

990 Ft. from N. Line

_____ Ft. from S. Line

_____ Ft. from E. Line

330 Ft. from W. Line

COMPLETED

Location _____

Rig up _____

Drilling and Remarks:

Sil 3285 corrected
Po 82569
Nat.

RECORD

Cased _____ in., _____ ft.

Sand _____

Gas _____

Oil _____

Total Depth 3273

PRODUCTION

1st 24 hrs. Nat. _____

1st 24 hrs. after shot _____

Gas _____ Cu. Ft.

Dry Hole _____

Abandoned _____

Date

SEP 9 1936

S. J. LEWIS

Scout