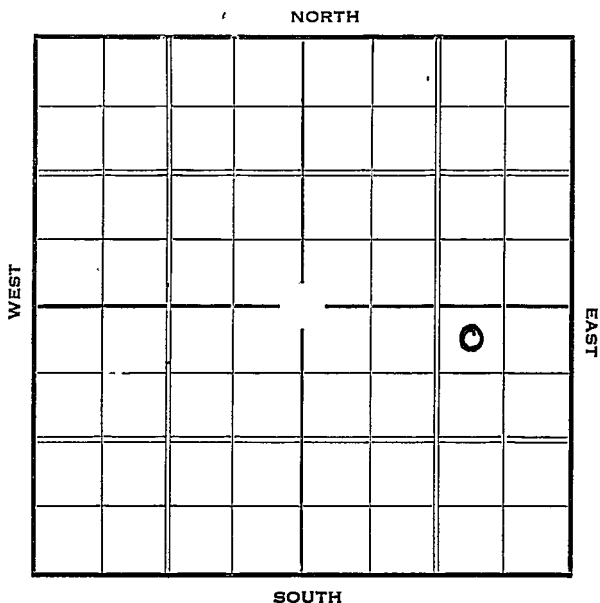


Section 36 Township 17 Range 11-WWell Number 3 - "A" Patzner "A"Company Spencer & Yarnell

KANSAS

Map No. 55 Sec. 36 Twp. 17 R. 11 W

Well No. 3-A Patzner A

Spencer & Yarnell Company

Contractor

SECTION PLAT

FIRST REPORT

			0
		"A" Lease	

380 Ft. from N. Line

 Ft. from S. Line

990 Ft. from E. Line

 Ft. from W. Line

Twin Well

Location

Rig up

Drilling and Remarks:

70"-180
diag 330

RECORD

Cased in., ft.

Sand

Gas

Oil

Total Depth

PRODUCTION

1st 24 hrs. Nat.

1st 24 hrs. after shot

Gas Cu. Ft.

Dry Hole

Abandoned

Date

APR 28 1937 19

H. D. Hatfield Scout

We show a #3 Patzner NW NE SE
36-17-11W Spencer, Yarnell et al
~~Completed~~ Completed well
Feet Measurements 330 N x 990 E

Is this a twin Well

Advise

Sam

Sam:

#3 Patzner was completed in the
K C lime and #3-"A" is a twin well
to be drilled to the Siliceous.

Returned	
Cards	
Tracing	
France Map	
Scarborough Map	
Moody Map	
Scarborough Plat Book	
Moody Plat Book	

Hatfield

Barton KANSAS

Map No. 55 Sec. 36 Twp. 17 R. 11WWell No. 3-A-Patzner "A" (Twin)Spencer & Earnell Company
Contractor

COMPLETED

SECTION PLAT

			o

580 Ft. from N. Line Ft. from S. Line990 Ft. from E. Line Ft. from W. LineLocation Rig up

Drilling and Remarks:

Pat 2714

RECORD

Cased 6 in., 3242 ft.Sand Si 3242Gas Oil Total Depth 3246

PRODUCTION

1st 24 hrs. Nat. 1st 24 hrs. after shot Gas Cu., Ft.Dry Hole Abandoned

Date

MAY 19 1937 19

H. D. Hatfield

Scout