


Section 36 Township 17 Range 11-W

Well Number 3 Germeinhardt 'A' (K65 DR)

Company Spencer & Yarnell

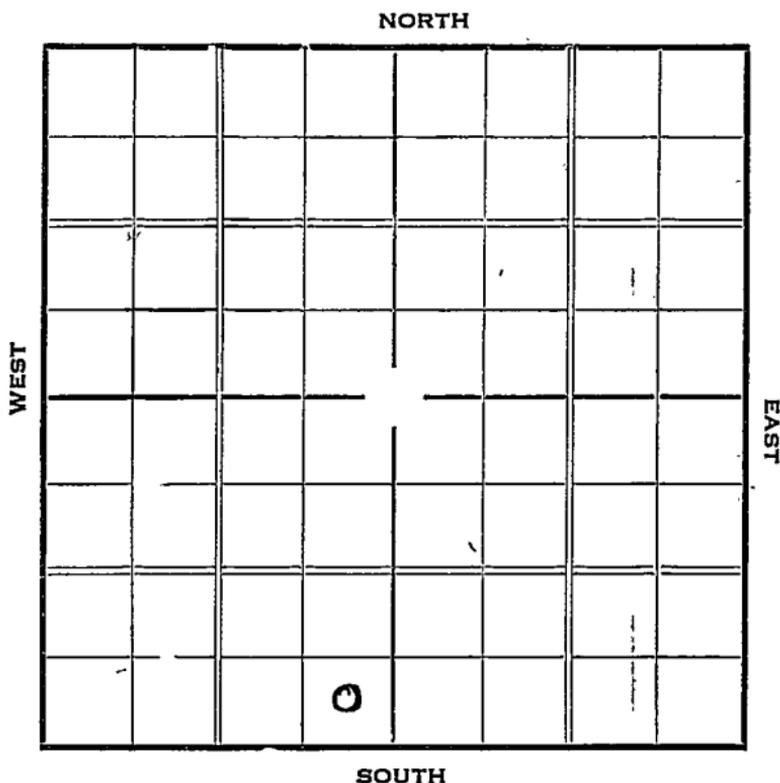

Sec. 36 Twp. 17 R. 11-W

Well No. #3 Germeinhardt 'A' (KGS DPL) Farm

Spencer & Yarnell Company


_____ Ft. from N. Line

330 Ft. from S. Line

330 Ft. from E. Line

_____ Ft. from W. Line

Elev. 1811

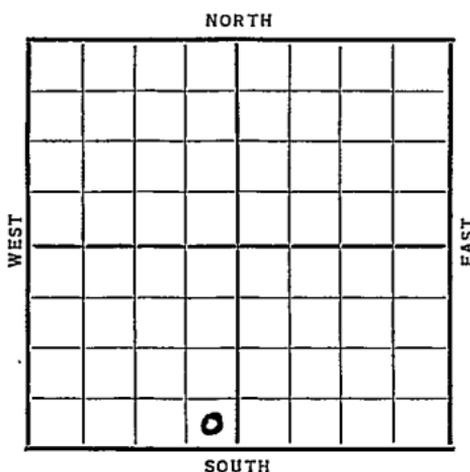

Date	REPORT
2/10	Cable rig.
2/10	Rigging up.
2/26	12" @ 355'. T.D. 591'
	Under ream 12"
3/4	12" @ 591'. Drlg. 1575'.
3/11	10" @ 1845'. Drlg. 2315'.
3/18	8" @ 2315'. Drlg. 3210'
3/24	Sil. 3304'.
	T. D. 3309'.
	Potential 1086 natural.
	COMPLETED

KANSAS

Map No. _____ Sec. 36 Twp. 17 R. 11WWell No. 3 Germeinhardt 'A'Spencer & Garnett (REG'D) Company

Contractor

SECTION PLAT

_____ Ft. from N. Line

330 Ft. from S. Line330 Ft. from E. Line

_____ Ft. from W. Line

FIRST REPORT

Location _____

Rig up _____

Drilling and Remarks:

Cable rig.

RECORD

Cased _____ in., _____ ft.

Sand _____

Gas _____

Oil _____

Total Depth _____

PRODUCTION

1st 24 hrs. Nat. _____

1st 24 hrs. after shot _____

Gas _____ Cu. Ft.

Dry Hole _____

Abandoned _____

Date

FEB 10 1937₁₉

S. J. LEWIS Scout

KANSAS *Barton*Map No. *35* Sec. *36* Twp. *17* R. *11W*Well No. *3 Germeinhardt 'A'**Spencer & Gammell* (KGS DRL) Company

Contractor

SECTION PLAT

_____ Ft. from N. Line

330 Ft. from S. Line*330* Ft. from E. Line

_____ Ft. from W. Line

COMPLETED

Location _____

Rig up _____

Drilling and Remarks:

*Oil 3304**Potential**1086 natural*

RECORD

Cased _____ in., _____ ft.

Sand _____

Gas _____

Oil _____

Total Depth *3309*

PRODUCTION

1st 24 hrs. Nat. _____

1st 24 hrs. after shot _____

Gas _____ Cu. Ft.

Dry Hole _____

Abandoned _____

Date

MAR 2 1937

19

S. J. LEWIS Scout