


Section 36 Township 17 Range 11-W

Well Number #4 Bloomer

Company Republic O & G

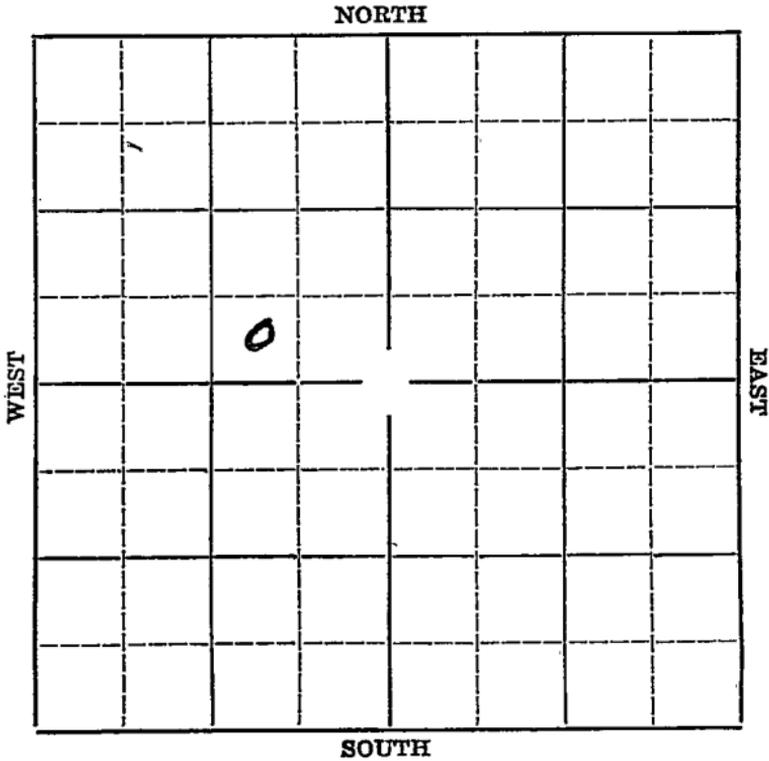


Sec. 36 Twp. 17 R. 11W

Well No. #4 Bloomer Farm
Republic O & G Company

_____ Ft. from N. Line
330' Ft. from S. Line
990' Ft. from E. Line
 _____ Ft. from W. Line

Elev. 1816

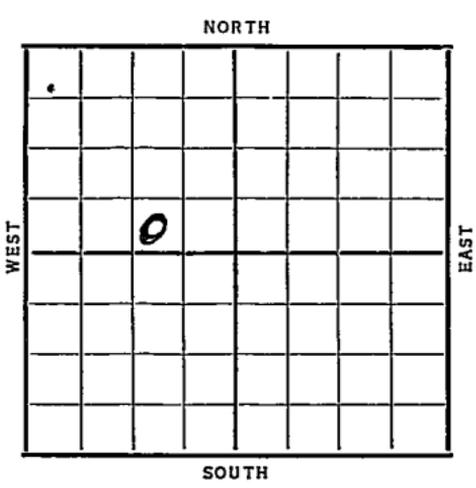

Date	REPORT
10/28	Cellar.
11/6	Rig
11/12-	Rigging up
11/19	10" @ 176'. Drlg. 2030'.
11/27	Drlg. 2880'.
12/3	Sil. 3275' set 6". T. D. 3280' Rust.
12/10	Bailing mud.
12/17	Pay 3284-86'. T. D. 3300'. 1000 acid. 223 bbls. in 7 hrs.
12/22	Sil. 3276'. 1000 acid. T. D. 3300'. Pot. 914.
COMPLETED	

Map No. 55 Sec. 36 Twp. 17 R. 11W

Well No. 4 Blosser

Republic Oil Co. Company

Contractor

SECTION PLAT

	0		

_____ Ft. from N. Line

230 Ft. from S. Line

990 Ft. from E. Line

_____ Ft. from W. Line

FIRST REPORT

Location _____

Rig up _____

Drilling and Remarks:

De Har

RECORD

Cased _____ in., _____ ft.

Sand _____

Gas _____

Oil _____

Total Depth _____

PRODUCTION

1st 24 hrs. Nat. _____

1st 24 hrs. after shot _____

Gas _____ Cu. Ft.

Dry Hole _____

Abandoned _____

Date

OCT 28 1936 19

S. J. LEWIS

Scout

KANSAS

Map No. 55 Sec. 36 Twp. 17 R. 11W

Well No. 4 Blower

Republic O & G Company

Contractor

SECTION PLAT

	0		

_____ Ft. from N. Line

330 Ft. from S. Line

990 Ft. from E. Line

_____ Ft. from W. Line

COMPLETED

Location _____

Rig up _____

Drilling and Remarks:

Sil 3276.
1000 acid
PO 8914

RECORD:

Cased _____ in., _____ ft.

Sand _____

Gas _____

Oil _____

Total Depth 3300

PRODUCTION

1st 24 hrs. Nat. _____

1st 24 hrs. after shot _____

Gas _____ Cu. Ft.

Dry Hole _____

Abandoned _____

Date

DEC 22 1936 19

S. J. LEWIS Scout