

KANSAS

Form 51-5M-4-36-Palace


Barton

O. W. P. B.

Section 36 Township 17 Range 11-W

Well Number #4-Bloomer

Company Skelly Oil

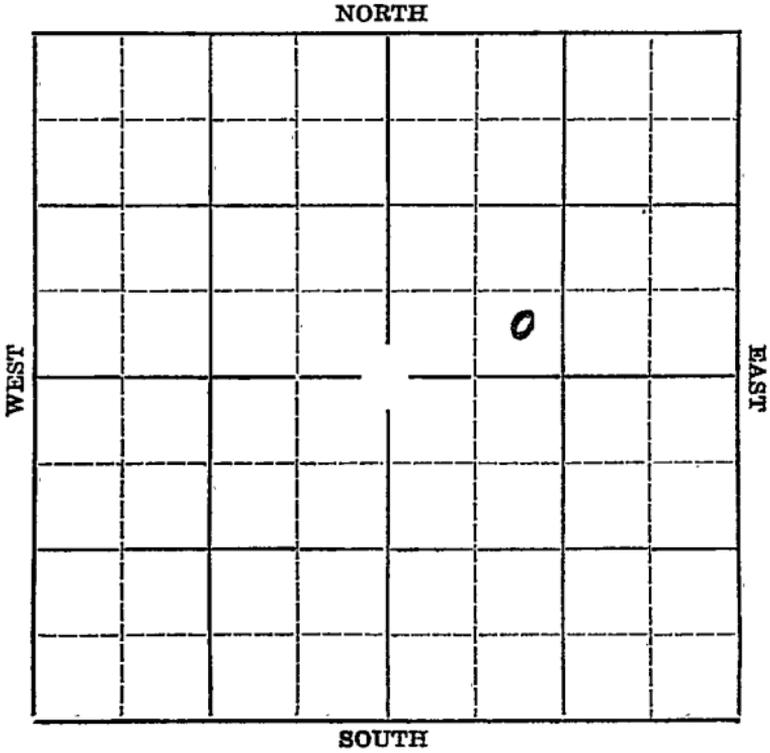

O. W. P. B.

Form 252-A—5M—7-36—Palace

KANSAS Barton

Sec. 36 Twp. 17 R. 11W

Well No. #4 Bloomer Farm

Skelly Oil Co. Company

NORTH

Ft. from N. Line


330' Ft. from S. Line

Ft. from E. Line

990' Ft. from W. Line

SE SW NE

Elev. 1816

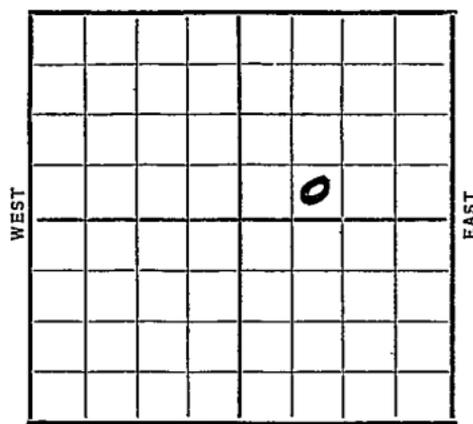

SOUTH

1936

REPORT

10/14 Rig on ground.

10/22 189' of 12". Waiting on cement.

10/29 Drlg. 2247'.

11/6 Sil 3265 Set 7" Rust

11/12 T. D. 3268 Fishing rods.

11/18 Sil. 3265 T. D. 3268

Pot. 2582 Nat.

COMPLETED

1955

O. W. P. B.

5/25 Oil well TD 3252 Lans 2973
 Arb. 3244 5" @ 3245 OTD 3252
 PB 3160 49/3148-56 3500 A S/1 BO
 15 BW 5 hr. PB 3137 49/3119-27
 2500 A S/3 BO 1 BW 12 hr. PB 3095
 47/3062-70 500 A S/52 BO 75 BWP
 PB 3046 48/3002-10 2500 A
 S/11 BO 3 hr. PB 2993 25/2988-92
 49/2974-82 500 A S/50 BO 13 BW
 9 hr. CO to 3214
 Comp. 88 BOPD 22 BW

FIRST REPORT

COMPLETED

Map No. 55 Sec. 36 Twp. 17 R. 11W

Well No. 4 Bloomer

Skelly Oil Company

Contractor

SECTION PLAT

| | | | |
|--|--|---|--|
| | | | |
| | | | |
| | | 0 | |
| | | | |

_____ Ft. from N. Line

330 Ft. from S. Line

_____ Ft. from E. Line

990 Ft. from W. Line

FIRST REPORT

Location _____

Rig up _____

Drilling and Remarks:

RCG

RECORD

Cased _____ in., _____ ft.

Sand _____

Gas _____

Oil _____

Total Depth: _____

PRODUCTION

1st 24 hrs. Nat. _____

1st 24 hrs. after shot _____

Gas _____ Cu. Ft.

Dry Hole _____

Abandoned _____

Date

OCT 14 1936

19

S. J. LEWIS

Scout

Map No. 55 Sec. 36 Twp. 17 R. 11W

Well No. 4 Bloomer

Skelly Oil Company

Contractor

SECTION PLAT

| | | | |
|--|--|--|--|
| | | | |
| | | | |
| | | | |
| | | | |

_____ Ft. from N. Line

330 Ft. from S. Line

_____ Ft. from E. Line

990 Ft. from W. Line

COMPLETED

Location _____

Rig up _____

Drilling and Remarks:

Oil 3265
Prod 2582. Nat.

RECORD

Cased _____ in., _____ ft.

Sand _____

Gas _____

Oil _____

Total Depth 3268

PRODUCTION

1st 24 hrs. Nat. _____

1st 24 hrs. after shot _____

Gas _____ Cu. Ft.

Dry Hole _____

Abandoned _____

Date

NOV 18 1938

S. J. LEWIS

Scout

~~O. W. P. B.~~

County Barton State Kansas
 Sec. 36 (Blk. 17) (Sur. 11W) (Twp.) (Rge.) Map No.

Operator Skelly OilWell No. 4 Farm J. B. BloomerElev. 1816 Location SE SW NE

| | | | | | |
|--|--|--|--|--|--|
| | | | | | |
| | | | | | |
330 Ft. From S Line NE.990 Ft. From W Line Quarter1st. Report MAY 25 1955Completion O. W. P. B.Remarks OWPB

Spudding Date

Drig. Data Oil well TD 3252Lans. 2973 Arb. 3244 5" @ 3.245OTD 3252 PB 3160 49/ 3148-563500 A S/ 1 bo 15 bw 5 hr. PB 313749/ 3119-27 2500 A S/ 3 bo 1 bw 12 hr.PB 3095 47/ 3062-70 500 A S/ 52 bo75 bwph PB 3046 48/ 3002-10 2500 AS/ 11 bo 3 hr. PB 2993 25/ 2988-9249/ 2974-82 500 A S/ 50 bo 13 bw 9 hr.CO to 3214 Comp. 88 bopd. 22 bw.