


Ellis

KANSAS

Section 14 Township 12 Range 16-W

Well Number 1 Smith

Company Billingo

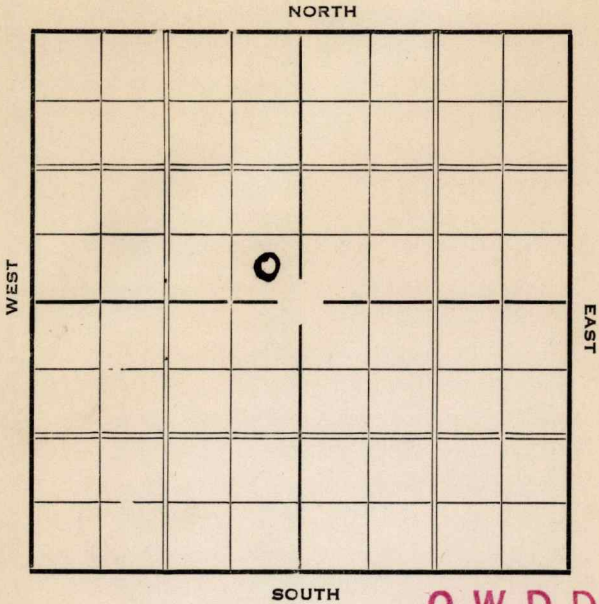


O. W. D. D

Sec. 14 Twp. 12 R. 16-W

Well No. #1 Smith Farm
Billingo Company

 Ft. from N. Line
330 Ft. from S. Line
330 Ft. from E. Line
 Ft. from W. Line

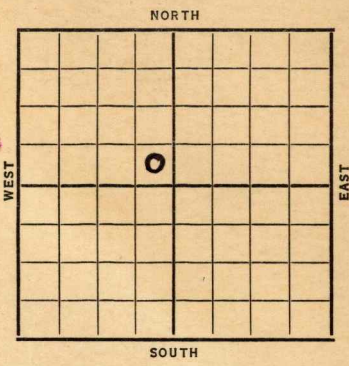

Elev. 1880

Date	REPORT O. W. D. D
1937	
3/31	Rig
4/8	Rigging up
4/16	Spud
4/23	"
4/30	15" @ 410'. 12" @ 550'. Drlg. 1005'.
5/7	10" @ 1021'. Anhy 1020' . Drlg. 1745'.
5/14	T.D. 2300'. C.O.
5/21	8" @ 2309'. Drlg, 2395'.
5/28	8" @ 2571'. T.D. 2627'. U.R.
6/4	8" @ 2761'. S.O. 2815-20 & 2874'. Drlg, 2915'.
6/11	Osw. 3083' . S.O. & W 3112- 3115'. S.G. 3185'. C.O.
6/19	6" @ 3185'. T.D. 3305'. Rng. 5".
	OVER

1937

6/25 Sil. 3356'. T.D. 3369'.
Pay 3363-64'. 5" @ 3350'.
800' oil in 8 hrs.

Swab 6 bbls. per hr 12 hrs.

7/2 T.D. 3370'. Swab 4 bbls. oil
per hr 16 hrs. Rig burned.

7/9 " " " " "

7/16 TD 3370' SD.

7/23 " "

7/30 " "

8/6 " "

8/13 " "

8/20 6" @ 3352'. T.D. 3370'.
2500 acid.

8/25 6" @ 3352'
Sil 3356'
TD 3370'
2500 acid
Pot 572'
Small s.w.

COMPLETED

1937

9/15

OTD 3370'
TD 3385'
Deepened to 3385'
4000 acid
Pot 572 (old pot)

O. W. D. D

FIRST REPORT

and

COMPLETED

Ellis

KANSAS

Map No. _____ Sec. 14 Twp. 12 R. 16^w

Well No. 1-Smith

Billings Company

Contractor

FIRST REPORT

COMPLETED

_____ Ft. from N. Line

330 Ft. from S. Line

330 Ft. from E. Line

_____ Ft. from W. Line

SECTION PLAT

		0	

O.W.D.D.

Location _____

Rig up _____

Drilling and Remarks:

OTD 3370

Deepened To 3385

4000 acid

Lot 572

(old Lot)

RECORD

Cased _____ in., _____ ft.

Sand _____

Gas _____

Oil _____

Total Depth 3385

PRODUCTION

1st 24 hrs. Nat. _____

1st 24 hrs. after shot _____

Gas _____ Cu. Ft.

Dry Hole _____

Abandoned _____

Date

SEP 15 1937

19

H. D. Hatfield

Scout

Ellis **KANSAS**

Map No. _____ Sec. 14 Twp. 12 R. 16^w

Well No. 1-Smith

Billings Company

Contractor _____

COMPLETED

SECTION PLAT

_____ Ft. from N. Line

330 Ft. from S. Line

330 Ft. from E. Line

_____ Ft. from W. Line

		0	

Location _____

Rig up _____

Drilling and Remarks:

2500 Acid

Pat-572
small sw.

RECORD

Cased 6 in., 3352 ft.

Sand 511 3356

Gas _____

Oil _____

Total Depth 3370

PRODUCTION

1st 24 hrs. Nat. _____

1st 24 hrs. after shot _____

Gas _____ Cu. Ft.

Dry Hole _____

Abandoned _____

Date

AUG 25 1937 19

H. D. Hatfield Scout

KANSAS *Ellis*

Map No. _____ Sec. 14 Twp. 12 R. 16W

Well No. 1 B Smith

Billings Company

Contractor

SECTION PLAT

	6		

_____ Ft. from N. Line

330 Ft. from S. Line

330 Ft. from E. Line

_____ Ft. from W. Line

FIRST REPORT

Location _____

Rig up _____

Drilling and Remarks:

Rig

RECORD

Cased _____ in., _____ ft.

Sand _____

Gas _____

Oil _____

Total Depth _____

PRODUCTION

1st 24 hrs. Nat. _____

1st 24 hrs. after shot _____

Gas _____ Cu. Ft.

Dry Hole _____

Abandoned _____

Date

MAR 31 1937

19

S. J. LEWIS Scout