

KANSAS


Barton

Form 51-5M-4-36-Palace

Section 36 Township 17 Range 11-W

Well Number #4-Bloomer

Company Texas

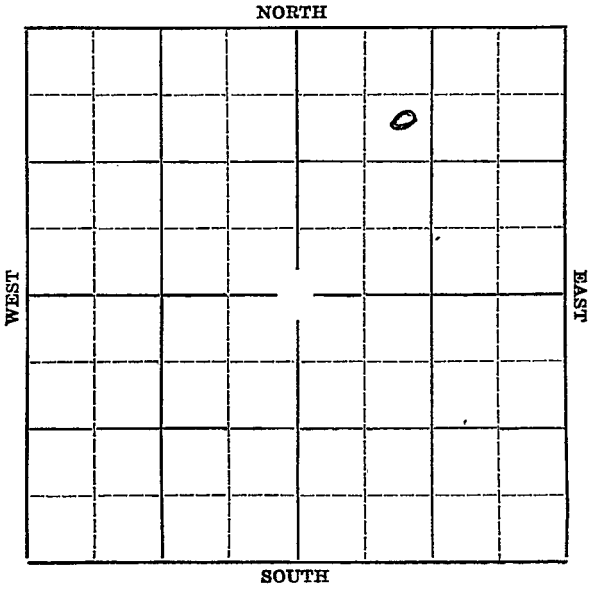

Sec. 36 Twp. 17 R. 11W

Well No. #4 Bloomer Farm _____
Texas Company _____


990' Ft. from N. Line

_____ Ft. from S. Line

_____ Ft. from E. Line

990' Ft. from W. Line

Elev. 1822

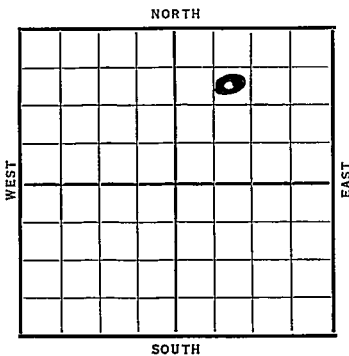

Date 1936

REPORT

9/2 Location.

9/10 10" @ 168'. WOC.

9/18 Drlg. 2059'.

9/24 Drlg. 3001'.

10/1 Siliceous 3275'. 7" @ 3276'.

Rigging up standard tools.

10/8 Same.

10/15 T.D. 3283'. Pump 645 bbls in
19 hours.

10/21/36-Sil. 3275'.

T.D. 3283'.

2000 gallons of acid.

1000 gallons of acid.

Potential 2387 bbls of oil.

COMPLETED

KANSAS

Map No. 55 Sec. 26 Twp. 17 R. 11W

Well No. 4 Bloomer

Texas Company

Contractor

SECTION PLAT

		0	

990 Ft. from N. Line

_____ Ft. from S. Line

_____ Ft. from E. Line

990 Ft. from W. Line

FIRST REPORT

Location ✓

Rig up _____

Drilling and Remarks:

RECORD

Cased _____ in., _____ ft.

Sand _____

Gas _____

Oil _____

Total Depth _____

PRODUCTION

1st 24 hrs. Nat. _____

1st 24 hrs. after shot _____

Gas _____ Cu. Ft.

Dry Hole _____

Abandoned _____

Date

SEP 2 1936

19

S. J. LEWIS Scout

KANSAS

Map No. 55 Sec. 36 Twp. 17 R. 11W

Well No. 4 Bloomer

Texas Company

Contractor

SECTION PLAT

		0	

990 Ft. from N. Line

_____ Ft. from S. Line

_____ Ft. from E. Line

990 Ft. from W. Line

COMPLETED

Location _____

Rig up _____

Drilling and Remarks:

Bit 3275

Acid 2000

" 1000

Potential

2387

RECORD

Cased _____ in., _____ ft.

Sand _____

Gas _____

Oil _____

Total Depth 3287

PRODUCTION

1st 24 hrs. Nat. _____

1st 24 hrs. after shot _____

Gas _____ Cu. Ft.

Dry Hole _____

Abandoned _____

Date

OCT 21 1936

19

S. J. LEWIS

Scout