

Barton


KANSAS

Form 51-5M-7-39-Palace

Section 36 Township 17 Range 11-W

Well No. #4 Gemeinhardt "A"

Company Spencer & Yarnell

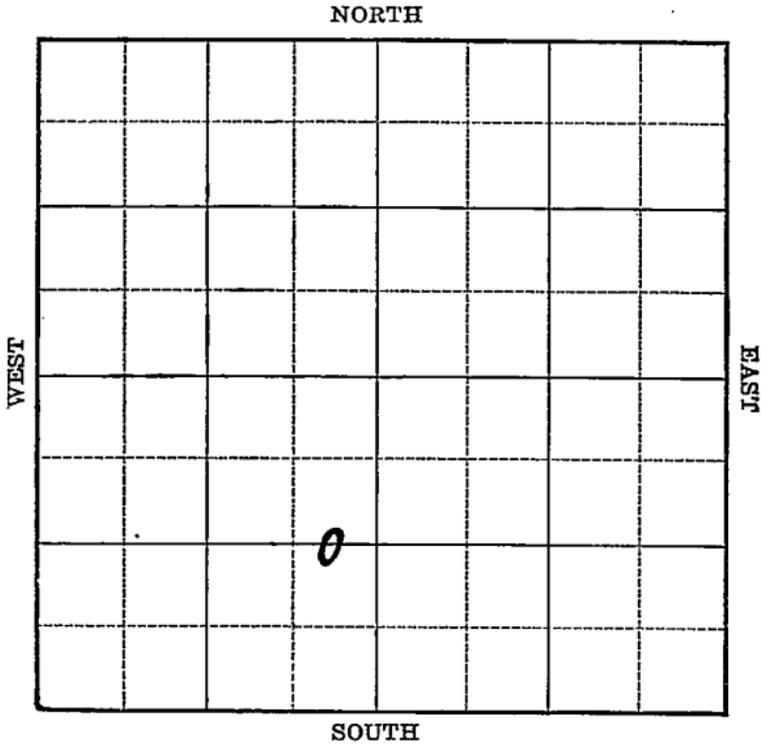

Sec. 36 Twp. 17 R. 11-W

Well No. #4 Gemeinhardt "A" Farm

Spencer & Yarnell Company

(Bloomer)


\_\_\_\_\_ Ft. from N. Line

1320 Ft. from S. Line

330 Ft. from E. Line

\_\_\_\_\_ Ft. from W. Line

Elev. 1814

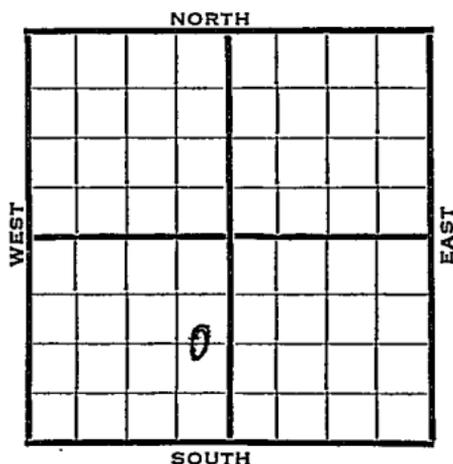

1940	REPORT
4/3	Cable.
4/12	15" - 100'
4/18	12" - 235' Anhy 582'
	590" U.R. 12"
4/25	935' lost hole.
	P.B. to 235' C.O.
5/2	12½" - 590' Drlg. 1275'
5/9	10" - 2067' Drlg. 2175'
5/16	8" - 2425' SSO 2980-90'
	Drlg. 3030'
5/22	Lans. 2970' Arb. 3291½-94' T.D.
	6" - 3291½' WOC.
5/29	" " "
6/5	Arb. 3291½'
	6" - 3291½'
	T.D. 3294'
	15 bbls. oil.
	<b>COMPLETED</b>

Barton KANSAS

Map No. 55 Sec. 36 Twp. 17 R. 11WWell No. 4 Gemeinhardt "A"Spencer & Yarnell

Company

Contractor

## FIRST REPORT

C E L SW

## SECTION PLAT


\_\_\_\_\_ Ft. from N. Line

1320 Ft. from S. Line330 Ft. from E. Line

\_\_\_\_\_ Ft. from W. Line

BLOOMER POOL

Location \_\_\_\_\_

Rig up \_\_\_\_\_

Drilling and Remarks:

Cable

## RECORD

Cased \_\_\_\_\_ in., \_\_\_\_\_ ft.

Sand \_\_\_\_\_

Gas \_\_\_\_\_

Oil \_\_\_\_\_

Total Depth \_\_\_\_\_

## PRODUCTION

1st 24 hrs. Nat. \_\_\_\_\_

1st 24 hrs. after shot \_\_\_\_\_

Gas \_\_\_\_\_ Cu. Ft.

Dry Hole \_\_\_\_\_

Abandoned \_\_\_\_\_

Date

APR 3 1940

19

S. J. LEWIS Scout

Map No. 55 Sec. 36 Twp. 17 R. 11WWell No. 4 Gemeinhardt "A"Spencer & Yarnell Company

Contractor

**COMPLETED****SECTION PLAT**

C E L SW

\_\_\_\_\_ Ft. from N. Line

1320 Ft. from S. Line330 Ft. from E. Line

\_\_\_\_\_ Ft. from W. Line


BLOOMER POOL

Location \_\_\_\_\_

Rig up \_\_\_\_\_

Drilling and Remarks:

*Cut 329 1/2**6" @ 329 1/2**157 ft.***RECORD**

Cased \_\_\_\_\_ in., \_\_\_\_\_ ft.

Sand \_\_\_\_\_

Gas \_\_\_\_\_

Oil \_\_\_\_\_

Total Depth 3294**PRODUCTION**

1st 24 hrs. Nat. \_\_\_\_\_

1st 24 hrs. after shot \_\_\_\_\_

Gas \_\_\_\_\_ Cu. Ft.

Dry Hole \_\_\_\_\_

Abandoned \_\_\_\_\_

Date

JUN 5 1940 19S. J. LEWIS Scout