


Section 14 Township 12 Range 16W

Well No. #2 Smith

Company Tom Palmer

Blue Hill Pool

NORTH

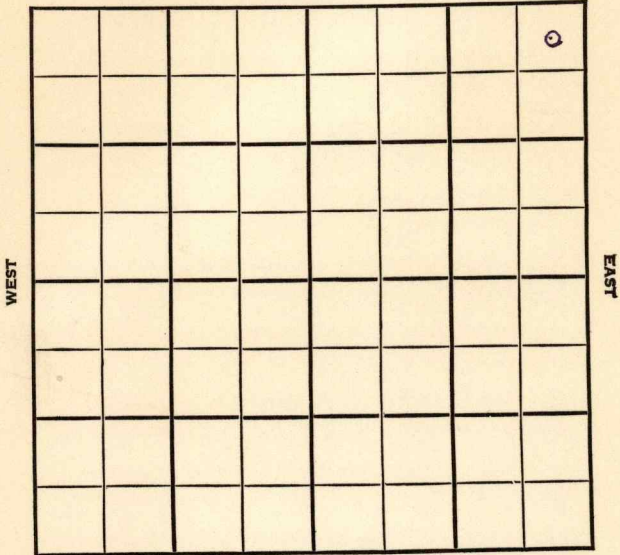

WEST

EAST

SOUTH

Sec. 14 Twp. 12 R. 16W

Well No. #2 Smith Farm
Tom Palmer Company

Blue Hill Pool


330' Ft. from N. Line

_____ Ft. from S. Line

330' Ft. from E. Line

_____ Ft. from W. Line

NE/C

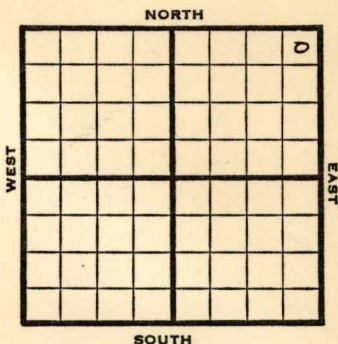

1948

#1 1842'

REPORT

3/31	Location
4/7	"
4/14	8" @ 655' Drlg. 1775'
4/21	2400 fsg.
4/28	Drlg. 2860'
5/5	Lansing 3049' 3265' fishing.
5/12	"
5/19	Arbuckle 3338' TD 3340' 5" @ 3340' RUST
5/26	"
6/1	"
6/9	"
6/16	TD 3354 $\frac{1}{2}$
6/23	2300 acid Pump 3 bbls oil PH 4 hrs.
6/29	"

OVER

1948

7/14

TD 3354 $\frac{1}{2}$

Arb. 3338'

5" @ 3340'

2300 acid

Pump 20 Oil / 10% W Pot

28° Gr.

Comp.

COMPLETED

Map No. 71 Sec. 14 Twp. 12 R. 16W

Well No. 2 Smith

Tom Palmer Company

COMPLETE

Contractor

NE/C

E. 1872

SECTION PLAT

330 Ft. from N. Line

_____ Ft. from S. Line

330 Ft. from E. Line

_____ Ft. from W. Line

			o

Ellis County

RECORD

Location _____

Cased _____ in., _____ ft.

Rig up _____

Sand _____

Drilling and Remarks:

Gas _____

Ar + 3338

Oil

5' @ 3340

Total Depth 3354 1/2

2300 ac. oil

PRODUCTION

Pump 20 oil + 10%

1st 24 hrs. Nat. _____

W.P.S.

1st 24 hrs. after shot _____

Gas _____ Cu. Ft.

Dry Hole _____

Abandoned _____

Date

JUL 14 1948

19

S. J. LEWIS Scout

Map No. _____ Sec. 14 Twp. 12 R. 16W

Well No. 2 Smith

Tom Palmer _____ Company

FIRST REPORT _____ Contractor

NE/C

SECTION PLAT

330 Ft. from N. Line

_____ Ft. from S. Line

330 Ft. from E. Line

_____ Ft. from W. Line

Ellis County

Location X

Rig up _____

Drilling and Remarks:

RECORD

Cased _____ in., _____ ft.

Sand _____

Gas _____

Oil _____

Total Depth _____

PRODUCTION

1st 24 hrs. Nat. _____

1st 24 hrs. after shot _____

Gas _____ Cu. Ft.

Dry Hole _____

Abandoned _____

Date

MAR 31 1948 19

S. J. LEWIS Scout