


Section 36 Township 17 Range 11-W

Well Number 4 Patzner "A"

ATLANTIC

Company Spencer Vassell et al

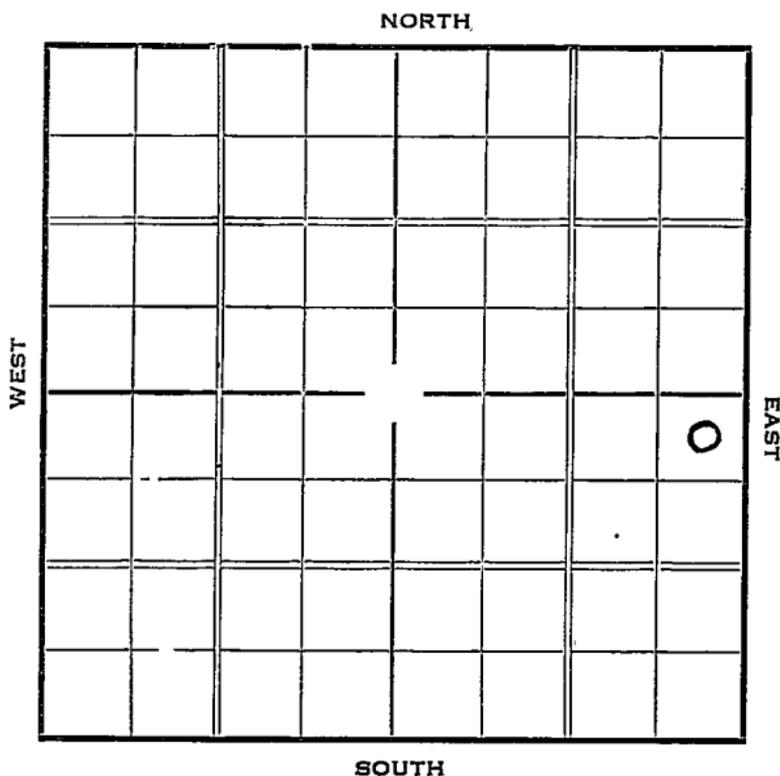

Sec. 36 Twp. 17 R. 11-W ✓

Well No. #4 Patzner Farm

Spencer Yarnell et al Company

O. W. P. B.


330 Ft. from N. Line

_____ Ft. from S. Line

330 Ft. from E. Line

_____ Ft. from W. Line

Elev. 1806

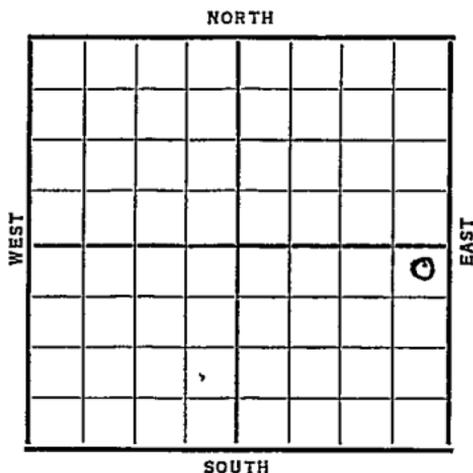

Date

REPORT

1937

3/24

R O G

4/2

Spud

4/8

10" @ 198' Drlg. 1997'

4/16

Drlg. 3025'.

4/23

Sil. 3236 1/2' set 7".

T.D. 3238 1/2'. Testing.

4/28

Sil. 3236 1/2'.

T.D. 3238 1/2'.

Pot. 2985 Natural.

1951

COMPLETED

O. W. P. B.

5/9

Oil Well TD 3111

Lans. 2956 Arb. 3236

OTD 3238 7" @ 3236 PB 3111

21/3037-44 16/3040-44

B/50 bopd 500 A

Comp. 381 bopd 34% w

FIRST REPORT

NEW LEADS

KANSAS *Boston*Map No. 53 Sec. 36 Twp. 17 R. 11W.Well No. 4 Patner*Spencer Garnell et al.* Company
Contractor

SECTION PLAT

			0

330 Ft. from N. Line

_____ Ft. from S. Line

330 Ft. from E. Line

_____ Ft. from W. Line

FIRST REPORT

Location _____

Rig up _____

Drilling and Remarks:

ROG

RECORD

Cased _____ in., _____ ft.

Sand _____

Gas _____

Oil _____

Total Depth _____

PRODUCTION

1st 24 hrs. Nat. _____

1st 24 hrs. after shot _____

Gas _____ Cu. Ft.

Dry Hole _____

Abandoned _____

Date

MAR 24 1937

19

S J. LEWIS Scout

Barton KANSAS

Map No. 55 Sec. 36 Twp. 17 R. 11 WWell No. 4 - PatznerSpencer & Yarnell Company
Contractor**COMPLETED**330 Ft. from N. Line

_____ Ft. from S. Line

330 Ft. from E. Line

_____ Ft. from W. Line

SECTION PLAT

			0

Location _____

Rig up _____

Drilling and Remarks:

Pot 2985
nat.**RECORD**

Cased _____ in., _____ ft.

Sand 511 - 3236 1/2

Gas _____

Oil _____

Total Depth 3238 1/2**PRODUCTION**

1st 24 hrs. Nat. _____

1st 24 hrs. after shot _____

Gas _____ Cu. Ft.

Dry Hole _____

Abandoned _____

Date

APR 28 1937

19

H. D. Hatfield Scout

