


Section 36 Township 17 Range 11-W

Well Number 6 - Patzner "A"

Company Spencer & Yarnell

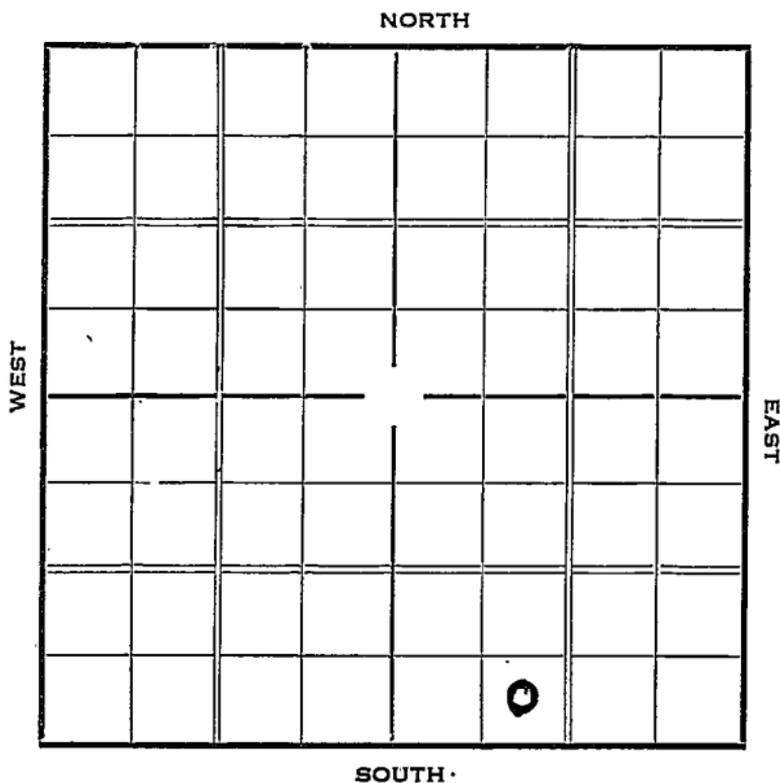

Barton **KANSAS**Map No. 55 Sec. 36 Twp. 17 R. 11WWell No. 6-Patzner "A"Spencer & Yarnell Company
Contractor**FIRST REPORT****SECTION PLAT**

11 Ft. from N. Line
330 Ft. from S. Line
 _____ Ft. from E. Line
990 Ft. from W. Line

		0	

Location _____

Rig up _____

Drilling and Remarks:

Cab. Rig.**RECORD**

Cased _____ in., _____ ft.

Sand _____

Gas _____

Oil _____

Total Depth _____

PRODUCTION

1st 24 hrs. Nat. _____

1st 24 hrs. after shot _____

Gas _____ Cu. Ft.

Dry Hole _____

Abandoned _____

Date

MAY 19 1937

H. D. Hatfield

19

Scout

Barton KANSAS

Map No. _____ Sec. 36 Twp. 17 R. 11 WWell No. 6-Patzner "A"Spencer + Yamell Company

Contractor

COMPLETED

SECTION PLAT

			0

_____ Ft. from N. Line

330 Ft. from S. Line

_____ Ft. from E. Line

990 Ft. from W. Line

Location _____

Rig up _____

Drilling and Remarks:

Pat 1714
nat.

RECORD

Cased 6 in., 3246 ft.Sand 511 3042

Gas _____

Oil _____

Total Depth 3247

PRODUCTION

1st 24 hrs. Nat. _____

1st 24 hrs. after shot _____

Gas _____ Cu. Ft.

Dry Hole _____

Abandoned _____

Date

JUL 7 1937 19

H. D. Hatfield

Scout