


Section 15 Township 12 Range 16W

Well No. #1 Froelich

Company Armer & Pickrell Drlg.

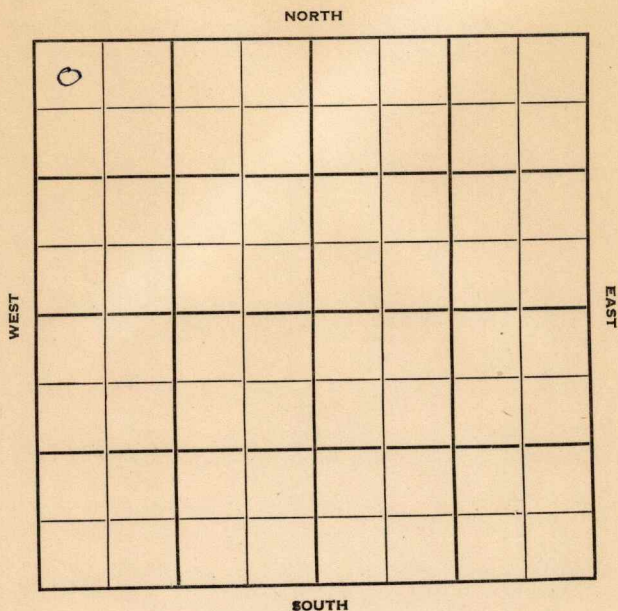

Ellis

KANSAS

Sec. 15 Twp. 12 R. 16W

Well No. #1 Froelich Farm

Armer & Pickrell Drlg. Company

Pickrell Drlg. Contractor

Wildcat


330' Ft. from N. Line

Ft. from S. Line

Ft. from E. Line

330' Ft. from W. Line

NW NW NW

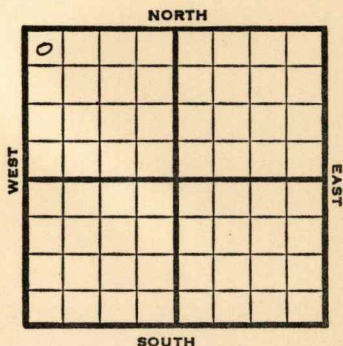

1950

Elev. 1862'

REPORT

3/15

Spud 3-10-50

8" @ 152'

Anhy 1020'

Drlg. 2025'

3/22

8"@ 152'

Anhy 1020'

Heebner 3036'

Toronto 3061'

Lans 3082'

Arb. 3400'

TD 3440'

D&A

Aband.

ABANDONED

Map No. _____ Sec. 15 Twp. 12 R. 16WWell No. 1 FroelichArmer & Pickrell Drlg. CompanyPickrell Drlg. Contractor

NW NW NW


El. 1862

SECTION PLAT

330 Ft. from N. Line

_____ Ft. from S. Line

_____ Ft. from E. Line

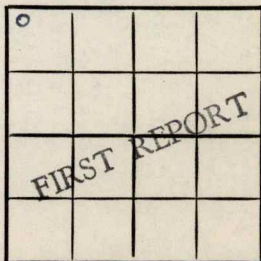330 Ft. from W. LineEllis CountyWestgate-Greenland DHM

Location _____

Rig up _____

Drilling and Remarks:

Spud 3-10-50

8" @ 152

Anhy 1020

drlg. 2025

RECORD

Cased _____ in., _____ ft.

Sand _____

Gas _____

Oil _____

Total Depth _____

PRODUCTION

1st 24 hrs. Nat. _____

1st 24 hrs. after shot _____

Gas _____ Cu. Ft.

Dry Hole _____

Abandoned _____

Date

MAR 15 1950 19J. E. TYRA Scout

Map No. _____ Sec. 15 Twp. 12 R. 16WWell No. 1 Froelich

Armer & Pickrell Drlg. _____ Company

Contractor _____

NW NW NW

E1. 1862

SECTION PLAT

330 Ft. from N. Line

_____ Ft. from S. Line

_____ Ft. from E. Line

330 Ft. from W. Line

Ellis County

Location _____

Rig up _____

Drilling and Remarks:

8" @ 152
 anky 1020
 Heubner 3036
 Toronto 3061
 Lane. 3082
 arbr. 3400
 T.D. 3440

D+A

RECORD

Cased _____ in., _____ ft.

Sand _____

Gas _____

Oil _____

Total Depth _____

PRODUCTION

1st 24 hrs. Nat. _____

1st 24 hrs. after shot _____

Gas _____ Cu. Ft.

Dry Hole _____

Abandoned _____

Date

MAR 22 1950 19

J. E. TYRA

Scout