

KANSAS


Ellis

FORM 51 5M PETROL

Section 18 Township 12 Range 16W

Well No. 1 P. A. Hoff

Company Fred Anschultz

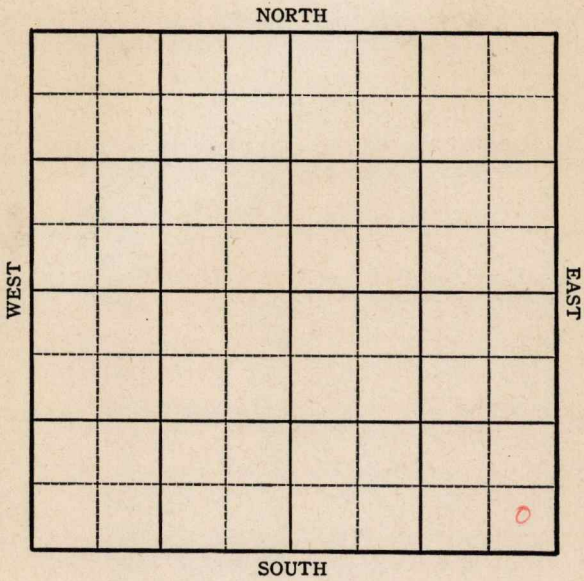

Sec. 18 Twp. 12 R. 16-W

Well No. #1 P. A. Hoff Farm

Fred Anschultz Company


 Ft. from N. Line

330 Ft. from S. Line

330 Ft. from E. Line

 Ft. from W. Line

SE/C

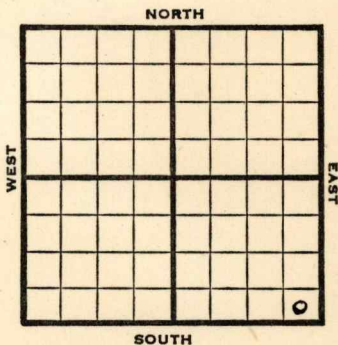

1945 **Elev. 2124** REPORT

11/21 8" 130' WOC

11/28 **Anhy. 1290**

Drlg. 2450'

12/5 Drlg. 3090'

12/12 **Lans 3365**

Arb. 3655

TD 3691'

ABANDONED

KANSAS Kansas Pool Name Wildcat

Map No. 71 Sec. 18 Twp. 12 R. 16W

Well No. 1 P.A. Hoff


Fred Anschultz Company

FIRST REPORT

Contractor

SE/C

SECTION PLAT

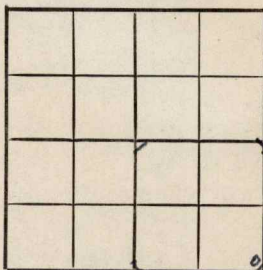

 Ft. from N. Line

330 Ft. from S. Line

330 Ft. from E. Line

 Ft. from W. Line

Ellis County

Location

Rig up

Drilling and Remarks:

8" @ 130 WOC

RECORD

Cased in., ft.

Sand

Gas

Oil

Total Depth

PRODUCTION

1st 24 hrs. Nat.

1st 24 hrs. after shot

Gas Cu. Ft.

Dry Hole

Abandoned

Date

NOV 21 1945 19

S. J. LEWIS Scout

KANSAS

Kansas


Pool Name WildcatMap No. K-91 Sec. 18 Twp. 12 R. 16WWell No. 1 P.A. HoffFred Anschultz

Company

ABANDONED

Contractor

SE/c

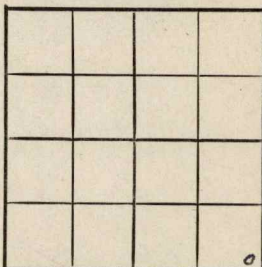E/2/24
SECTION PLAT Ft. from N. Line330 Ft. from S. Line330 Ft. from E. Line Ft. from W. LineEllis CountyLocation Rig up

Drilling and Remarks:

Lease 3365CR 33655**RECORD**Cased in., ft.Sand Gas Oil Total Depth 3691**PRODUCTION**1st 24 hrs. Nat. 1st 24 hrs. after shot Gas Cu. Ft.Dry Hole Abandoned

Date

DEC 12 1945 19S. J. LEWIS

Scout