


KANSAS

Section.....36.....Township.....17.....Range.....11W.....

Well Number...5...Bloomer.....

Company......Skelly.....

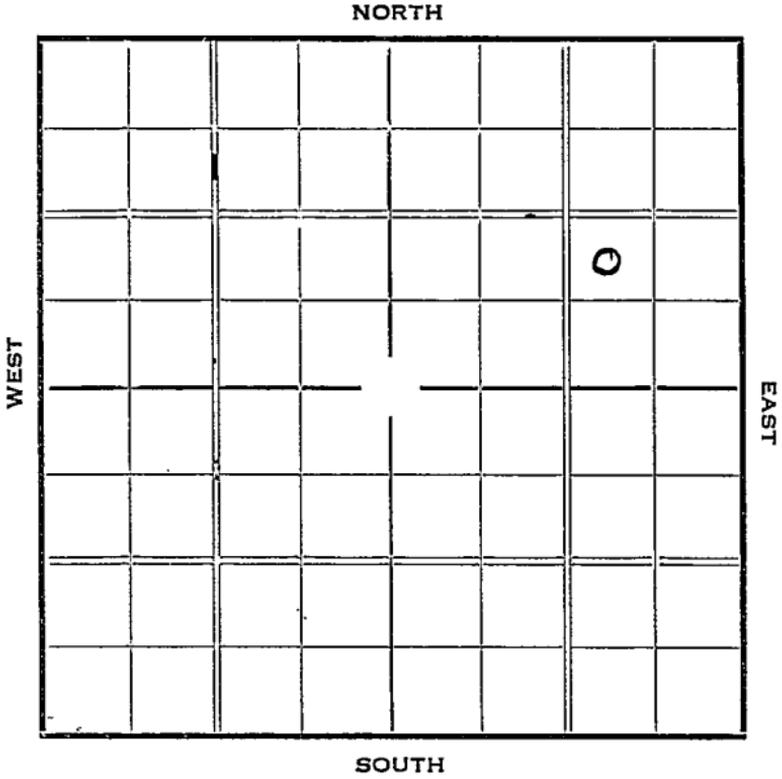

Sec. 36 Twp. 17 R. 11-W

Well No. #5 Bloomer Farm

Skelly Company


_____ Ft. from N. Line

990 Ft. from S. Line

990 Ft. from E. Line

_____ Ft. from W. Line

Elev. 1816

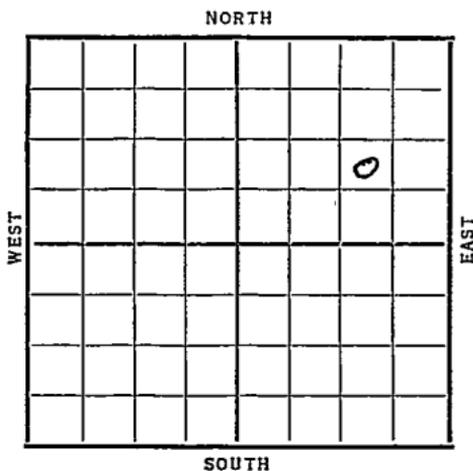

Date 1938	REPORT
11/25	Rigging up
12/3	12" @ 205'. Drlg. 1700'.
12/10	Drlg. 3007'.
12/17	Sil. 3269' set 7". RUST.
12/22	Sil. 3269'. 1000 acid.
	T. D. 3275'.
	Pot. 2713!
	COMPLETED

Map No. 53 Sec. 36 Twp. 17 R. 11WWell No. 5 Blomcr.Shelby Company

Contractor

SECTION PLAT

			0

 Ft. from N. Line990 Ft. from S. Line990 Ft. from E. Line Ft. from W. Line

FIRST REPORT

Location Rig up

Drilling and Remarks:

Rigging up

RECORD

Cased in., ft.Sand Gas Oil Total Depth

PRODUCTION

1st 24 hrs. Nat. 1st 24 hrs. after shot Gas Cu. Ft.Dry Hole Abandoned

Date

NOV 25 1936

19

S. J. LEWIS Scout

KANSAS

Map No. 55 Sec. 36 Twp. 17 R. 11W

Well No. 5 Bloomer

Skelly Company

Contractor

SECTION PLAT

			0

_____ Ft. from N. Line

990 Ft. from S. Line

990 Ft. from E. Line

_____ Ft. from W. Line

COMPLETED

Location _____

RECORD

Cased _____ in., _____ ft.

Sand _____

Gas _____

Oil _____

Total Depth 3275

Rig up _____

Drilling and Remarks:

Sil 3262
1000 acid
Per 2713

PRODUCTION

1st 24 hrs. Nat. _____

1st 24 hrs. after shot _____

Gas _____ Cu. Ft.

Dry Hole _____

Abandoned _____

Date

DEC 22 1936 19

S. J. LEWIS Scout