

Section 36 Township 17 Range 11W

Well No. 5 Gemeinhardt "A"

Company Atlantic

Kraft- Prusa Pool

NORTH

WEST

EAST

D

SOUTH

Sec. 36 Twp. 17 R. 11-W

Well No. #5 Gemeinhardt "A" Farm


Atlantic Company
Kraft-rusa Pool

990 Ft. from N. Line

_____ Ft. from S. Line

990 Ft. from E. Line

_____ Ft. from W. Line

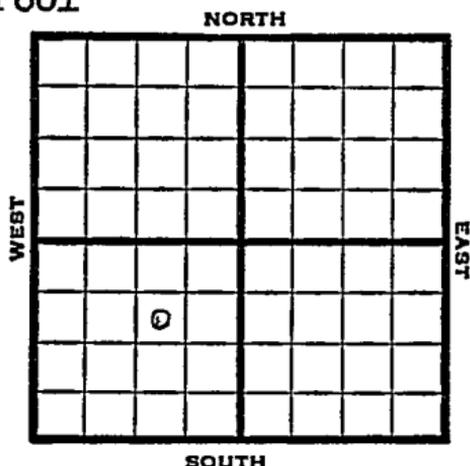

SW NE SW

1948

Elev 1813' REPORT

12/22
12/29

Location
"

1/5

RUR

1/12
1/19

10" @ 202 Drlg 1570
Drlg 3196'

1/26

Lansing 2994'
Arb. 3282-87'
TD 3287'

2/2

5" @ 3283'
Swb 1½ bbls oil PH 4 hrs.
1000 acid
Pump 22 bbls oil & 33 W in 20 hrs.

2/9

"

2/16

"

2/23

TD 3287'
Arb. 3282'
5" @ 3283'
1000 acid
Pump 20 oil / W Pot
42° Gr.
Comp

COMPLETED

Kansas

Map No. _____ Sec. 36 Twp. 17 R. 11WWell No. 5 Gemeinhardt "A"Atlantic

Company

FIRST REPORT

Contractor

SW NE SW


SECTION PLAT

990 Ft. from N. Line

_____ Ft. from S. Line

990 Ft. from E. Line

_____ Ft. from W. Line

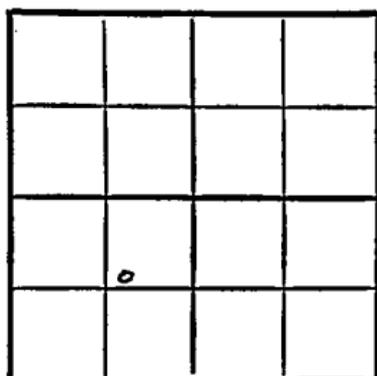

Barton County

RECORD

Location X

Cased _____ in., _____ ft.

Rig up _____

Sand _____

Drilling and Remarks:

Gas _____

Oil _____

Total Depth _____

PRODUCTION

1st 24-hrs. Nat: _____

1st 24 hrs. after shot _____

Gas _____ Cu. Ft.

Dry Hole _____

Abandoned _____

Date

DEC 22 1948 19S. J. LEWIS Scout

Kansas

Map No. K52 Sec. 36 Twp. 17 R. 11W

Well No. 5 Gemeinhardt "A"

Atlantic Company

COMPLETE

Contractor

SW NE SW

E. 1173

SECTION PLAT

990 Ft. from N. Line

 Ft. from S. Line

990 Ft. from E. Line

 Ft. from W. Line

Barton County

Location _____

Rig up _____

Drilling and Remarks:

Cert 3282
5" 03283
15000 cu ft
Pump 2000 ft + 2040 ft
H2O Sec

RECORD

Cased _____ in., _____ ft.

Sand _____

Gas _____

Oil _____

Total Depth 2289

PRODUCTION

1st 24 hrs. Nat. _____

1st 24 hrs. after shot _____

Gas _____ Cu. Ft.

Dry Hole _____

Abandoned _____

Date

FEB 23 1949 19

S. J. LEWIS

Scout