


Section 36 Township 17 Range 11-W

Well No. #5 Patzner "A"

Company Spencer & Yarnell

NORTH Bloomer Pool

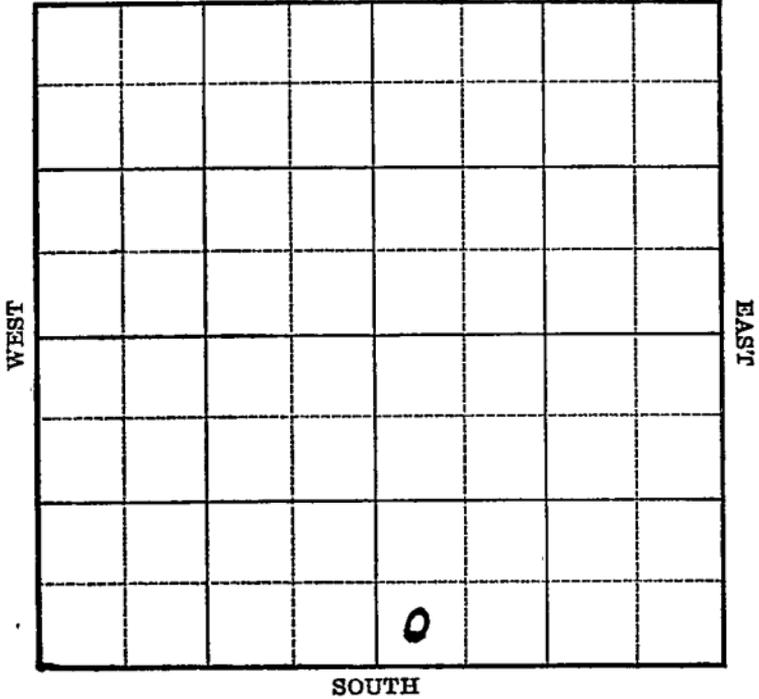

Sec. 36 Twp. 17 R. 11-W

Well No. #5 Patzner "A" Farm

Spencer & Yarnell Company

(Bloomer)


00 Ft. from N. Line

330 Ft. from S. Line

 Ft. from E. Line

330 Ft. from W. Line

Elev. 1808

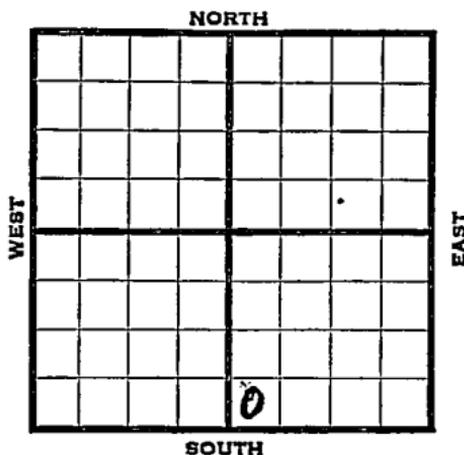

1939	REPORT
1/11	RUCT.
1/20	Spud.
1/27	15" - 81'.. Anhy 570'.
	12" - 578'. Drlg. 1220'.
2/3	10" - 1896'. Drlg. 2305'.
2/10	8" - 2650'. S.S.O. 2978-80'.
	Drlg. 2985'.
2/17	Arb. 3248-51' T. D. S. O.
	7" - 3249' WOC.
2/21	7" - 3249'
	Arb. 3248'
	T.D. 3254'
	1000 acid.
	Pump 621 bbls. 8 hours.
	Potential 1863 bbls.
	COMPLETED

