


KANSAS Ellis

Section 14 Township 12 Range 16W

Well No. 6 Smith "A"

Company J.J. Hall

Benish Pool

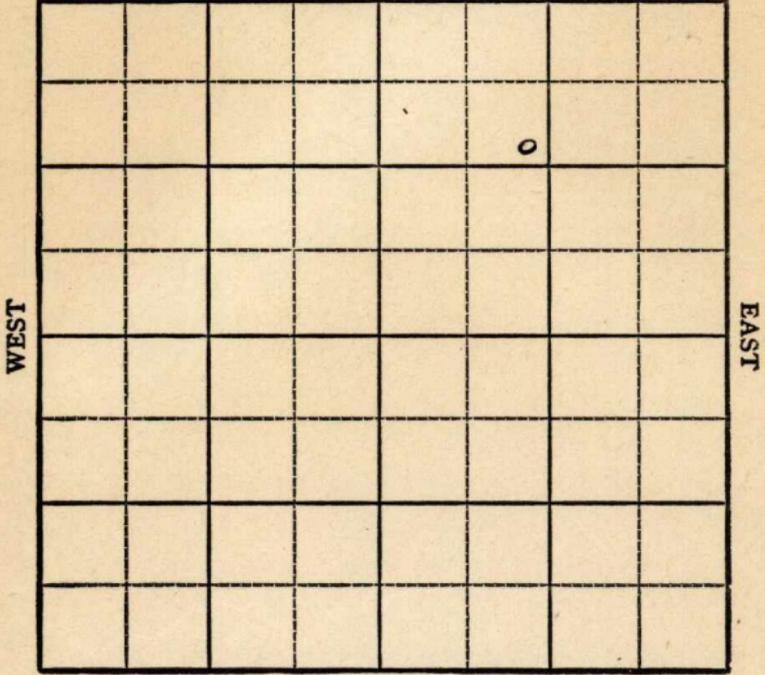

SOUTH

Sec. 14 Twp. 12 R. 16-W

Well No. #9 Smith "A" Farm
J J Hall Company


Bemis

990
~~1305~~ Ft. from N. Line

_____ Ft. from S. Line

_____ Ft. from E. Line

990
~~1020~~ Ft. from W. Line

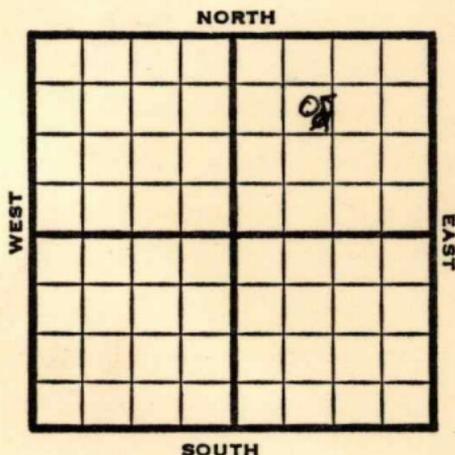

SE NW NE,

1948 **Elev 1869'** REPORT

12/22	RUR
12/29	10"@ 1005'
	Drlg 1060'
1/5	Drlg. 2495'
1/12	Topeka 2750, Lansing 3069
	BKC 3318 Arbuckle 3353
	TD 3365 Running Csg.
1/19	5"@ 3359'
1/26	"
2/2	TD 3376'
	Plug 3319
	36 shots to 3294-3302
2/9	3000 acid
	HFW squeeze
2/16	"
2/23	"
3/2	"
3/8	"
3/16	"
3/23	"
3/30	"
4/6	TD 3376'
	Lans. 3069'
	Arb 3353'
	5"@ 3359'
	1000 acid
	Pump 75 Oil Pot
	36° Gr.
	Comp

COMPLETED

Map No. _____ Sec. 14 Twp. 12 R. 16W

Well No. 9 Smith "A"

J. J. Hall Company

FIRST REPORT

Contractor

SE NW NE

SECTION PLAT

1305 Ft. from N. Line

_____ Ft. from S. Line

_____ Ft. from E. Line

1020 Ft. from W. Line

Ellis County

RECORD

Location _____

Cased _____ in., _____ ft.

Rig up _____

Sand _____

Drilling and Remarks:

Gas _____

Oil _____

Total Depth _____

R U R

PRODUCTION

1st 24 hrs. Nat. _____

1st 24 hrs. after shot _____

Gas _____ Cu. Ft.

Dry Hole _____

Abandoned _____

Date

DEC 22 1948

19

S. J. LEWIS

Scout

Map No. 71 Sec. 14 Twp. 12 R. 16W

Well No. 6 Smith "A"

J. J. Hall

Company

CORRECTION

Contractor

SE NW NE


SECTION PLAT

990 Ft. from N. Line

_____ Ft. from S. Line

_____ Ft. from E. Line

990 Ft. from W. Line

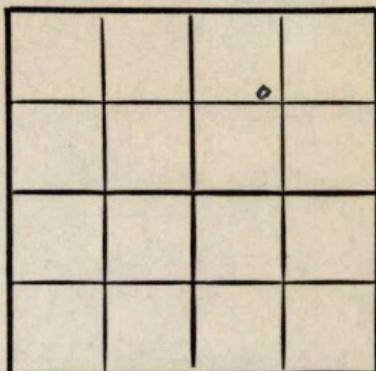

Ellis County

RECORD

Location _____

Cased _____ in., _____ ft.

Rig up _____

Sand _____

Drilling and Remarks:

Gas _____

Oil _____

Reported as

Total Depth _____

#9 Smith "A"

PRODUCTION

1st 24 hrs. Nat. _____

1st 24 hrs. after shot _____

Gas _____ Cu. Ft.

Dry Hole _____

Abandoned _____

Date

JAN 12 1949 19

S. J. LEWIS

Scout

Kansas

Map No. 71 Sec. 14 Twp. 12 R. 16W

Well No. 6 Smith "A"

J. J. Hall Company

COMPLETE

Contractor

SE NW NE

990 SB

1305 Ft. from N. Line

_____ Ft. from S. Line

_____ Ft. from E. Line

990

1020 Ft. from W. Line

SB

Ellis County

E. J. 11769
SECTION PLAT

		0	

Location _____

Rig up _____

Drilling and Remarks:

4 on 3068

CR 73803

5" casing

1000 acid

Pump to oil pad

36 2/3

RECORD

Cased _____ in., _____ ft.

Sand _____

Gas _____

Oil _____

Total Depth 3276

PRODUCTION

1st 24 hrs. Nat. _____

1st 24 hrs. after shot _____

Gas _____ Cu. Ft.

Dry Hole _____

Abandoned _____

Date

APR 6

1949

19

S. J. LEWIS

Scout