


Section 36 Township 17 Range 11-W

Well Number 6 Bloomer

Company Texas

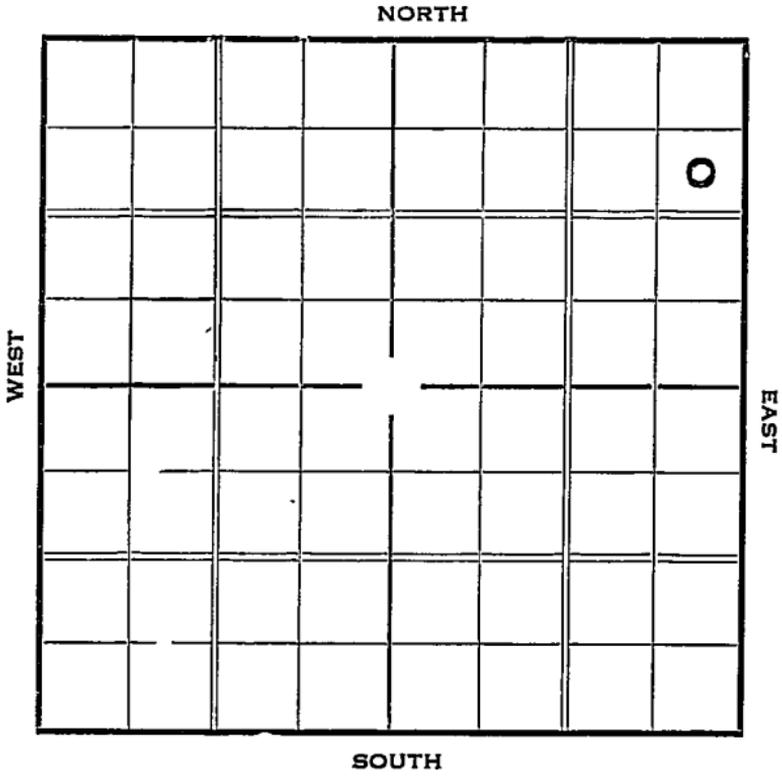

Sec. 36 Twp. 17 R. 11-W

Well No. #6 Bloomer Farm

Texas Company


990 Ft. from N. Line

_____ Ft. from S. Line

330 Ft. from E. Line

_____ Ft. from W. Line

Elv. 1821

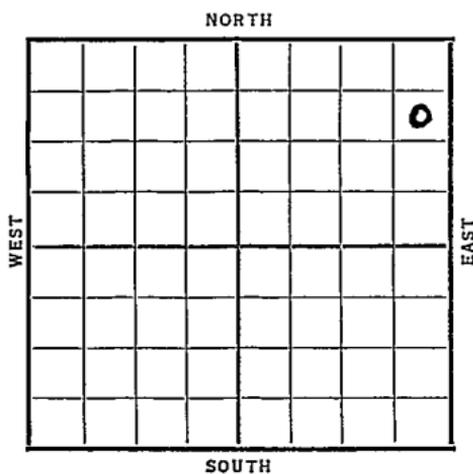

1937

REPORT

2/10 Location

2/19 Rig

2/26 12" @ 179'. Drlg. 600'.

3/4 Drlg. 1905'.

3/11 Drlg. 2855'.

3/18 Sil 3272'.

7" @ 3273 RUST

3/25 " " "

3/31 Sil. 3272'.

T. D. 3286'.

1000 acid.

Potential 1513. 20% water.

COMPLETED

Map No. _____ Sec. 36 Twp. 17 R. 11W

Well No. 6 Bloomer

Texas Company

Contractor _____

SECTION PLAT

			0

990 Ft. from N. Line

_____ Ft. from S. Line

330 Ft. from E. Line

_____ Ft. from W. Line

FIRST REPORT

Location ✓

Rig up _____

Drilling and Remarks:

RECORD

Cased _____ in., _____ ft.

Sand _____

Gas _____

Oil _____

Total Depth _____

PRODUCTION

1st 24 hrs. Nat. _____

1st 24 hrs. after shot _____

Gas _____ Cu. Ft.

Dry Hole _____

Abandoned _____

Date

FEB 10 1937 19

S. J. LEWIS Scout

Map No. 53 Sec. 36 Twp. 17 R. 11W

Well No. 6 Bloomer

Texas Company

Contractor

SECTION PLAT

			0

990 Ft. from N. Line

_____ Ft. from S. Line

330 Ft. from E. Line

_____ Ft. from W. Line

COMPLETED

Location _____

Rig up _____

Drilling and Remarks:

Si 63272.
1000 acid
Potential
1513 - 20%
water

RECORD

Cased _____ in., _____ ft.

Sand _____

Gas _____

Oil _____

Total Depth 3286

PRODUCTION

1st 24 hrs. Nat. _____

1st 24 hrs. after shot _____

Gas _____ Cu. Ft.

Dry Hole _____

Abandoned _____

Date

MAR 31 1937 19

S. J. LEWIS Scout