

Barton KANSAS


O.W.W.O.

KANSAS

Section 36 Township 17 Range 11W

Well Number 6 Bloomer

Company ~~Skelly~~ Skelly

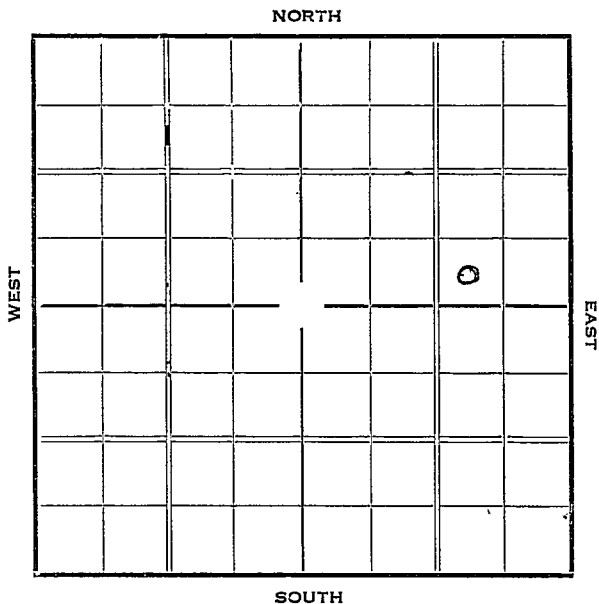

O.W.W.O.

Form 252-A-5M-7-36-Palace

KANSAS


Barton

KANSAS

Sec. 36 Twp. 17 R. 11-WWell No. #6 Bloomer FarmSkelly Company Ft. from N. Line330 Ft. from S. Line990 Ft. from E. Line Ft. from W. Line

SWSENE

Elev. 1818

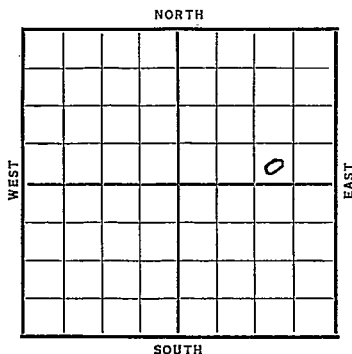Date
1936

REPORT

11/25 Rigging up

12/3 10" @ 196'. Drlg. 1865'.

12/10 Sil. 3270' set 7".

12/17 T. D. 3273'. Pump 2522 bbls.
20 hrs.12/22 Sil. 3270'. T. D. 3273'.
Pot. 2733. Nat.

COMPLETED

1955
7/13

O.W.W.O.

Old info: Lans 2964', Arb. 3239'
 OTD 3253'. 5" @ 3240 - Was Arb. Prod.
 NEW INFO: PB 3215; 125/3142-62, 3800
 total acid. Swb 44 BO + 26 BW 24 hrs.
 PB 3125' Perf 42/3111-18; 2000 acid
 Swab 36-BO + 20 BW 16 hrs. PB 3086'
 Perf 73/3052-64; 1000 acid. Swab 1
 BO 11 hrs. PB 3035' Perf 60/3012-22
 500 A Swab 3 GWPH - 5 hrs. PB 3003'
 Perf 24/2994-99; 3000 total acid.
 Swab 15 BO + 14 BW 6 hrs. PB 2985'
 Perf 25/2978-82; 49/2964-74; 3500
 total acid. Swb 82 BO no wtr. 24 hrs.
 DP 3205 P/40 BO + 60 BW 24 hrs.
 IP: P/22 BOPD + 65% wtr. from Lans.
 perfs 2964-3162' - COMPLETE

FIRST REPORT COMPLETED

Map No. 58 Sec. 36 Twp. 17 R. 11W

Well No. 6. Bloomer

Skelly Company
Contractor

SECTION PLAT

 Ft. from N. Line

330 Ft. from S. Line

990 Ft. from E. Line

 Ft. from W. Line

FIRST REPORT

Location

Rig up

Drilling and Remarks:

Rigging up.

RECORD

Cased in., ft.

Sand

Gas

Oil

Total Depth

PRODUCTION

1st 24 hrs. Nat.

1st 24 hrs. after shot

Gas Cu. Ft.

Dry Hole

Abandoned

Date

NOV 25 1936 19

S. J. LEWIS

Scout

KANSAS

Map No. 55 Sec. 36 Twp. 17 R. 11W

Well No. 6 Bloomer

Skelly Company

Contractor

SECTION PLAT

			0

 Ft. from N. Line

330 Ft. from S. Line

990 Ft. from E. Line

 Ft. from W. Line

COMPLETED

Location

Rig up

Drilling and Remarks:

Si 63270

Pa 82733

Nat.

RECORD

Cased in., ft.

Sand

Gas

Oil

Total Depth 3273

PRODUCTION

1st 24 hrs. Nat.

1st 24 hrs. after shot

Gas Cu. Ft.

Dry Hole

Abandoned

Date

DEC 22 1936

S. J. LEWIS Scout

O.W.W.O.

O W W O

FORM 513 REV. SUNRAY

County Barton Elev. 1813 DF
 Sec. 36 Twp. 17S Rge. 11W
 Company Skelly Oil Co.
 FarmName J. R. Bloomer No. 6

TOPS	DEPTH	LOG	DATUM
Anh.			
Tp.			
H.			
Tr.			
Dg.			
BL.			
L.	<u>2964</u>		
K.C.			
B.K.C.			
Ce.			
C.			
M.			
M.			
K.			
Mz.			
Mq.			
V.			
S.			
S.			
A	<u>3239</u>		
R.			
PE.			
G.			
T.D.	<u>3253</u>		

Loc. in Sec.

SW SE NE

Geol.

Contr.

Pool

Bloomer

COMPLETE

JUL 13 55

FIRST-REPORT

Date Comm.

Old info: Las 2964; Arb 3239; OTD 3253;
 5" 3240 - was Arb Prod.

New info: PB 3215; 125/3142-62; 3800 total
 Acid; Swb 14 bo plus 26 bw 24 hrs.; PB
 3125; perf 42/3111-18; 2000 Acid; Swb 36 bo
 plus 20 bw 16 hrs.; PB 3086; perf 73/3052-
 64; 1000 Acid; Swb 1 bo 11 hrs.; PB 3035;
 Perf 60/3012-22; 500A Swb 3 gwph -5hrs.;

OVER

PB 3003; perf 24/2994-99; 3000 total acid; Swb 15 bo plus 14 bw 6 hrs.; PB 2985; perf 25/2978-82; 49/2964-74; 3500 total acid; Swb 82 bo no wtr. - 24 hrs.; DP 3205 - P 40 bo plus 60 bw 24 hrs.

IPP 22 bopd plus 65% wtr. from Lans. perfs.
2964-3162

Complete

JUL 18 1955

_____	Misc.
_____	Piece Map
_____	Trace Map
_____	Tracings
_____	Land Wall Map
_____	Land Small Map
_____	Scout Cards

[Handwritten signature]