

Section 36 Township 17 Range 11W

Well No. 6 Patzner "A" - "K"

Company Atlantic

Bloomer

NORTH

WEST

EAST

SOUTH

0

KANSAS

Barton

Sec. 36 Twp. 17 R. 11W

Well No. #6 Patzner "A" - "K" Farm

Atlantic Company

Bloomer Pool


Ft. from N. Line

330' Ft. from S. Line

Ft. from E. Line

1090' Ft. from W. Line

SE SW SE

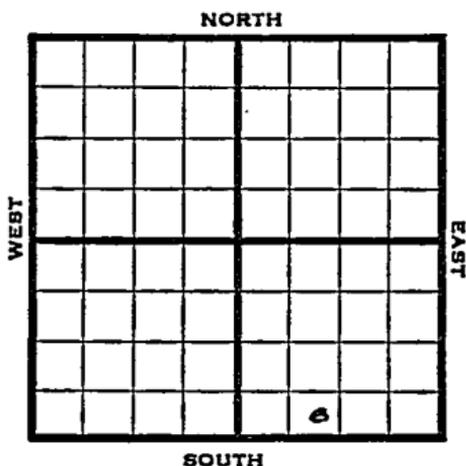

1948

REPORT

- 3/10 Twin Well
Lansing Test
Loc.
- 3/17 "
- 3/24 8" @ 332'
Drlg. 440'
- 3/31 Drlg. 2590'
- 4/7 Lansing 2967'
TD 3247'
5" @ 3247'
RUST
- 4/14 " ●
- 4/21 "
- 4/28 72 shots 2990-98'
1000 acid
Swab 11 bbls. oil PH 2 hrs
- 5/5 - "
- 5/12 - "
- 5/19 Lans. 2967'-
5" @ 3247'
Perf
1000 Acid
Pump 292 oil & 2% W Pot.
Gr. 42°
TD 3247'

COMPLETED

Map No. _____ Sec. 36 Twp. 17 R. 11W

Well No. 6. Patzner "A" - "K"

Atlantic Company

FIRST REPORT

Contractor _____

SE SW SE

SECTION PLAT

_____ Ft. from N. Line

330 Ft. from S. Line

_____ Ft. from E. Line

1090 Ft. from W. Line

Barton County

Location X

Rig up _____

Drilling and Remarks:

twin well

Lansing test

RECORD

Cased _____ in., _____ ft.

Sand _____

Gas _____

Oil _____

Total Depth _____

PRODUCTION

1st 24 hrs. Nat. _____

1st 24 hrs. after shot _____

Gas _____ Cu. Ft.

Dry Hole _____

Abandoned _____

Date

MAR 10 1948

19

S. J. LEWIS

Scout

Map No. 55 Sec. 36 Twp. 17 R. 11W

Well No. 6 Patzner "A" - "K"

Atlantic Company

COMPLETE

Contractor

SE SW SE

E. I. 1908.
SECTION PLAT

 Ft. from N. Line

330 Ft. from S. Line

 Ft. from E. Line

1090 Ft. from W. Line

Barton County

Location

Rig up

Drilling and Remarks:

Loss 2967
5" C3247
Prof.
1600 acid
Pump 292 oil +
2 1/2 W Pat
42 2/3

RECORD

Cased in., ft.

Sand

Gas

Oil

Total Depth 2247

PRODUCTION

1st 24 hrs. Nat.

1st 24 hrs. after shot

Gas Cu. Ft.

Dry Hole

Abandoned

Date

MAY 19 1948 19

S. J. LEWIS Scout