


Section 36 Township 17 Range 11-W

Well Number 7 Bloomer

Company Texas

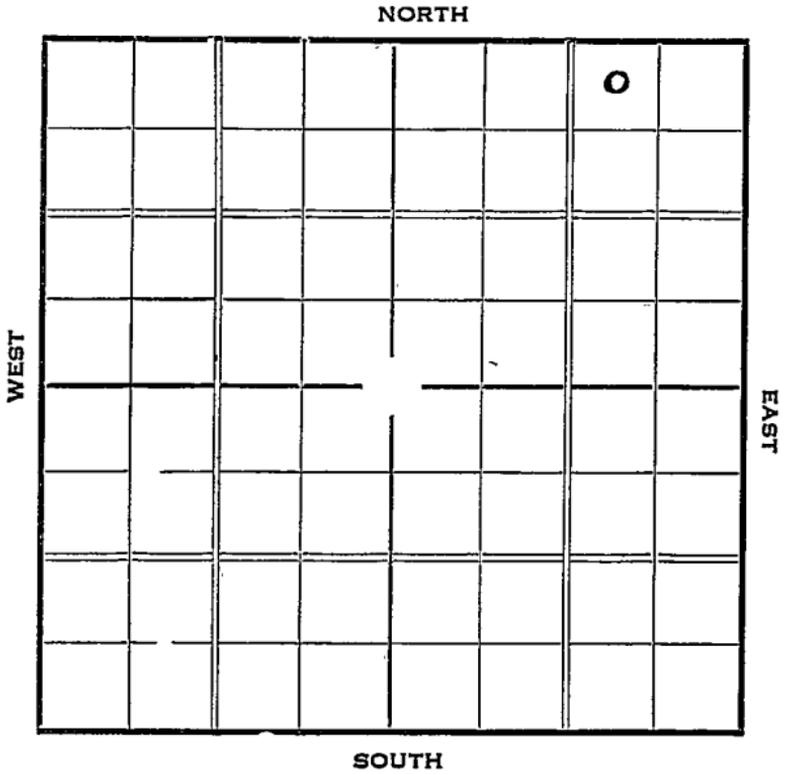


Sec. 36 Twp. 17 R. 11-WWell No. #7 Bloomer FarmTexas Company330 Ft. from N. Line

\_\_\_\_\_ Ft. from S. Line

990 Ft. from E. Line

\_\_\_\_\_ Ft. from W. Line

Elev. 1822

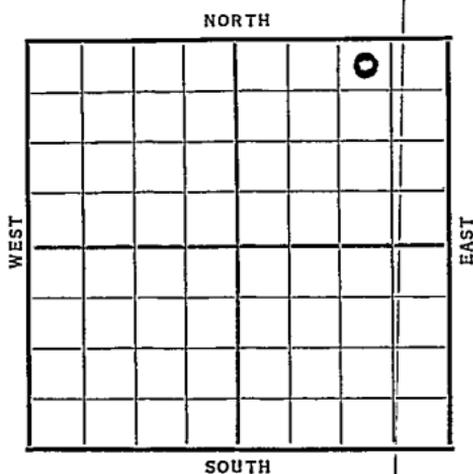

Date

REPORT

2/10 Location

2/19 Cellar

2/26 Rig.

3/4 10 @ 192'. WOC.

3/11 Drlg. 500'.

3/18 Drlg. 2535'

3/25 Sil. 3304' Drlg.

4/2 Sil. 3291' (Corrected)

7" @ 3290'. T.D. 3296' RUST

4/8 3300 T.D. 2000 acid pump 115 bbl  
oil 6% water 6 hrs.

4/14 Sil. 3291'.

T.D. 3303'.

3000 acid.

Potential 940, 23% water.

**COMPLETED**

Map No. \_\_\_\_\_ Sec. 36 Twp. 17 R. 11W

Well No. 7 Bloomer

Texas, \_\_\_\_\_ Company

\_\_\_\_\_ Contractor

### SECTION PLAT

			0

330 Ft. from N. Line

\_\_\_\_\_ Ft. from S. Line

990 Ft. from E. Line

\_\_\_\_\_ Ft. from W. Line

### FIRST REPORT

Location ✓

Rig up \_\_\_\_\_

Drilling and Remarks:

### RECORD

Cased \_\_\_\_\_ in., \_\_\_\_\_ ft.

Sand \_\_\_\_\_

Gas \_\_\_\_\_

Oil \_\_\_\_\_

Total Depth \_\_\_\_\_

### PRODUCTION

1st 24 hrs. Nat. \_\_\_\_\_

1st 24 hrs. after shot \_\_\_\_\_

Gas \_\_\_\_\_ Cu. Ft.

Dry Hole \_\_\_\_\_

Abandoned \_\_\_\_\_

Date

FEB 10 1937 19

S. J. LEWIS Scout

**KANSAS** *Barton*

Map No. 55 Sec. 36 Twp. 17 R. 11W

Well No. 7 Bloomer

Texas Company

Contractor

**SECTION PLAT**

			o

330 Ft. from N. Line

\_\_\_\_\_ Ft. from S. Line

990 Ft. from E. Line

\_\_\_\_\_ Ft. from W. Line

**COMPLETED**

Location \_\_\_\_\_

Rig up \_\_\_\_\_

Drilling and Remarks:

*Sil 3291*

*3000 acid*

*Potential*

*940 - 2.3% water*

**RECORD**

Cased \_\_\_\_\_ in., \_\_\_\_\_ ft.

Sand \_\_\_\_\_

Gas \_\_\_\_\_

Oil \_\_\_\_\_

Total Depth 3303

**PRODUCTION**

1st 24 hrs. Nat. \_\_\_\_\_

1st 24 hrs. after shot \_\_\_\_\_

Gas \_\_\_\_\_ Cu. Ft.

Dry Hole \_\_\_\_\_

Abandoned \_\_\_\_\_

Date

APR 14 1937

19

S. J. LEWIS

Scout