


Section 1 Township 17 Range 12W

Well No. #1 Hitchman

Company Sohie & B & R Drlg.

NORTH

4

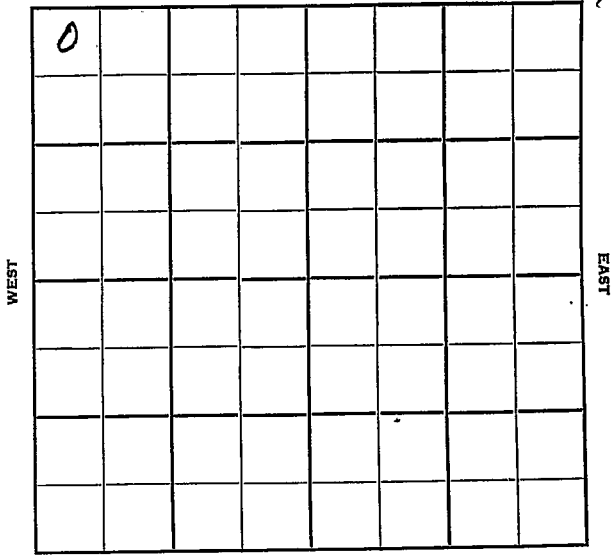

SOUTH

WEST

EAST

Barton

KANSAS

Sec. 1 Twp. 17 R. 12W

Well No: #1 Hitchman Farm

Sohio & B & R Drlg. Company

B & R Drlg.
Wildcat Contractor


330 Ft. from N. Line

Ft. from S. Line

Ft. from E. Line

330 Ft. from W. Line

NW NW NW

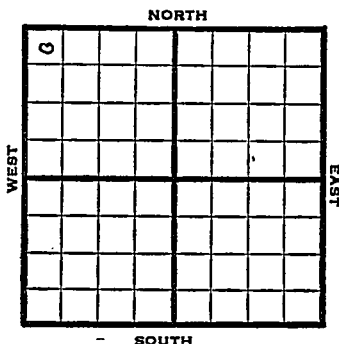

Sunray DHM

1952 Elev. 1914' REPORT

1/2 Spud 12-28-51
8" @ 300
Drlg. 1690'

1/16 Spud 12-28-51
D&A TD 3450
8" @ 300 Top. 2680
DST 2947-60 open 1 hr. rec. 20'
mud & SW Heeb. 3001 Tor. 3017
DST 3008-30 open 1 hr. rec. 30' mud
& SSO Br Li 3098 Lans. 3110
DST 3143-55 open 1 hr. rec. 50' mud
DST 3217-25 open 1 hr. rec. 30' mud
& SW Arb. 3380 TD 3450
D&A

ABANDONED

County Barton State Kansas

Sec. 1 (Blk.) 17 (Sur.) 12W Map No.

Operator Sohio & B & R Drlg.

Well No. 1 Farm Hitchman

Elev. _____ Location NW NW NW

0					

330 Ft. From N Line NW

330 Ft. From W Line Quarter

Ist. Report JAN 2 1952

Completion _____

Remarks Sunray - DHM

B & R Drlg. - Contr.

Spudding Date 12-28-51

Drlg. Data Wildcat

8" @ 300 drlg. 1690

J. E. TYRA

County Barton State Kansas

Sec. 1 (Blk. 17) (Sur. 12W) (Twp.) (Rge.) Map No.

Operator Sohio & B & R Drlg.

Well No. 1 Farm Hitchman

Elev. 1914 Location NW NW NW

0					

330 Ft. From N Line NW

330 Ft. From W Line Quarter

Ist. Report

Completion JAN 16 1952

Remarks Wildcat

B & R Drlg. - Contr,

Spudding Date 12-28-51

Drlg. Data D & A TD 3450

8" @ 300 Top. 2680 DST 2947-60 open

1 hr. Rec. 20' mud & sw Heeb. 3001

Tor. 3017 DST 3008-30 open 1 hr.

Rec. 30' mud & SSO Br. lime 3098

Lans. 3110 DST 3143-55 open 1 hr.

Rec. 50' mud DST 3217-25 open 1 hr.

Rec. 30' mud & sw Arb. 3380

TD 3450 D & A