

Section 22 Township 12 Range 16W

Well No. #1 Forelick

Company Petroleum, Inc.

Emmerman Pool

NORTH

WEST

EAST

0

SOUTH

Ellis

KANSAS

16W

Sec. 22

Twp.

12

R.

Well No. #1 Forelick

Farm

Petroleum, Inc.

Company

Ft. from N. Line

330'


Ft. from S. Line

330'

Ft. from E. Line

Ft. from W. Line

SE SW

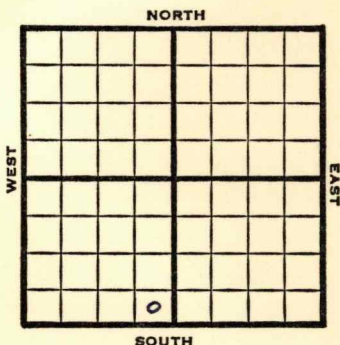

1949

Elev 1988'

REPORT

12/7

Location

12/14

8" @ 225'

Dr1g. 2850'

12/21

Lansing 3199'

Arb. 3469'

TD 3470'

5"@ 3469'

12/28

"

1950

2/1

TD 3495'

8"@ 225'

5"@ 3469'

Plug back to 3320'

Perf 24/3278-84'

P 195 BOPD

Heeb 3147'

Lans 3199'

Arb. 3469'

Comp

COMPLETED

Kansas

Map No. _____ Sec. 22 Twp. 12 R. 16WWell No. 1 Forelick

Petroleum Inc.


Company

Contractor

SE SW

FIRST REPORT

SECTION PLAT

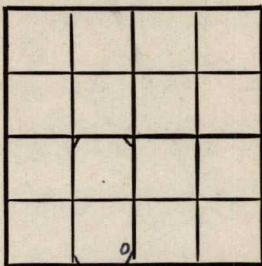

_____ Ft. from N. Line

330 Ft. from S. Line330 Ft. from E. Line

_____ Ft. from W. Line

Ellis County

Location X

Rig up _____

Drilling and Remarks:

RECORD

Cased _____ in., _____ ft.

Sand _____

Gas _____

Oil _____

Total Depth _____

PRODUCTION

1st 24 hrs. Nat. _____

1st 24 hrs. after shot _____

Gas _____ Cu. Ft.

Dry Hole _____

Abandoned _____

Date

DEC 7

1949

19

S. J. LEWIS

Scout

Kansas

Map No. _____ Sec. 22 Twp. 12 R. 16WWell No. 1 Forelick

Petroleum Inc.

Company

Contractor

SE SW

E1. 1988
SECTION PLAT

____ Ft. from N. Line

330 Ft. from S. Line330 Ft. from E. Line

____ Ft. from W. Line

COMPLETE			

Ellis County

Location _____

Rig up _____

Drilling and Remarks:

8" @ 225

5" @ 3469

Plug BACK to 3320

Perf 24/3278-84

P. 195 B.O.P.D

RECORD

Cased _____ in., _____ ft.

Sand _____

Gas _____

Oil _____

Total Depth 3495

PRODUCTION

1st 24 hrs. Nat. _____

1st 24 hrs. after shot _____

Gas _____ Cu. Ft.

Dry Hole _____

Abandoned _____

Date

J. E. TYRA

FEB 1 1950

19

Scout

Key 3147
Ans 3199
Ans 3469

Map No. _____

Well No. _____

Company _____

Contractor _____

SECTION PLAT

COMPLETE			

_____ Ft. from N. Line

_____ Ft. from S. Line

_____ Ft. from E. Line

_____ Ft. from W. Line

RECORD

Cased _____ in _____ ft.
Sand _____
Gas _____
Oil _____

Location _____

Rig _____

Drilling and Remarks _____

FEB

7 1950

- Scout Cards
- Land Small Map
- Land Wall Map
- Tracings
- France Map
- Pierce Map
- Misc.

Date _____