


Section 3 Township 12 Range 17W

Well No. 1 Windholtz

Company E. Overland Drlg. & Dreiling

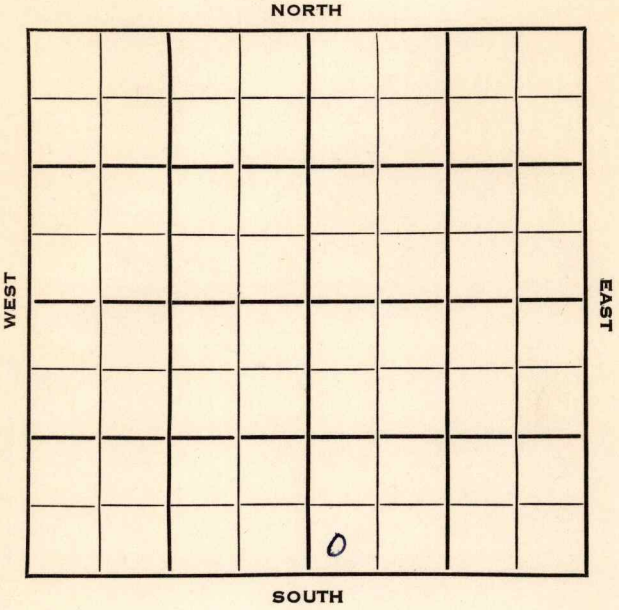



Sec. 3 Twp. 12 R. 17 W

Well No. # 1 Windholtz Farm

E. Overland Drlg. & Dreiling Company

Overland Drlg. Contractor


Ft. from N. Line

330 Ft. from S. Line

Ft. from E. Line

330 Ft. from W. Line

SW SW SE

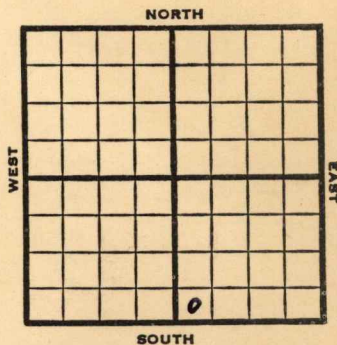

1952 **Elev. 2116'** REPORT

- 12/10 Spud 12-6-52
8" @ 150
Drlg. 1114'
- 12/11 " "
- 12/18 Ø3142
- 12/25 " "
- 12/30 Spud 12-6-52
D&A
TD 3690
8" @ 150
Anhy 1320, Heeb. 3306, Lans 3353
DST 3437-48, opn 1/2 hr., rec. 28'
wtr., 740#
Simp 3605, Arb. 3615
DST 3623-38, opn 1/2 hr., rec. 15' mud, 0#
DST 3635-65, opn 1 1/2 hrs., rec. 45' mud, 500#
TD 3690
D&A

ABANDONED

