



Sec. 2 Twp. 17 R. 12W

Well No. 1 Rief Farm

Tom Palmer Company

Oden Pool


330 Ft. from N. Line

\_\_\_\_\_ Ft. from S. Line

330 Ft. from E. Line

\_\_\_\_\_ Ft. from W. Line

NE SW

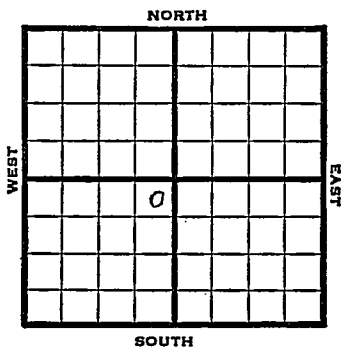

1948

Eli 1906'

REPORT

8/25

8" @ 235'  
Anhy 805'

9/1

Drlg. 1610'  
Lansing 3083'  
Cong 3369'  
Arb. 3390'  
TD 3410'  
Aband

**ABANDONED**

Barton County Kansas State

Map No. \_\_\_\_\_ Sec. 2 Twp. 17 R. 12W

Well No. 1 Rief

Tom Palmer Company

**FIRST REPORT**

Contractor

NE SW


**SECTION PLAT**

330 Ft. from N. Line

\_\_\_\_\_ Ft. from S. Line

330 Ft. from E. Line

\_\_\_\_\_ Ft. from W. Line

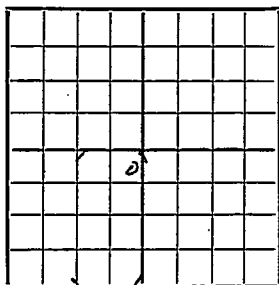

Oden Pool

Remarks:

8" @ 235 Anhy 805 drlg. 1610

Date  
AUG 25 1948

Scout **S. J. LEWIS**

