


Section 36 Township 17 Range 11-W

Well Number 8 Bloomer

Company Texas

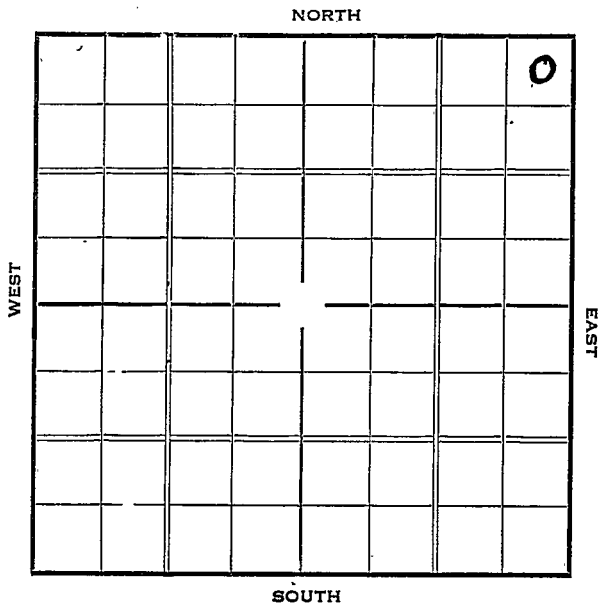

Map No. _____ Sec. 36 Twp. 17 R. 11W

Well No. E Bloomer

Texas Company

Contractor _____

SECTION PLAT

			0

330 Ft. from N. Line

_____ Ft. from S. Line

330 Ft. from E. Line

_____ Ft. from W. Line

FIRST REPORT

Location _____

Rig up _____

Drilling and Remarks:

Rig

RECORD

Cased _____ in., _____ ft.

Sand _____

Gas _____

Oil _____

Total Depth _____

PRODUCTION

1st 24 hrs. Nat. _____

1st 24 hrs. after shot _____

Gas _____ Cu. Ft.

Dry Hole _____

Abandoned _____

Date

MAR 31 1937 19 _____

S. J. LEWIS Scout

Barton KANSAS

Map No. _____ Sec. 36 Twp. 17 R. 11WWell No. S-BloomerTexas Company

Contractor _____

COMPLETED

SECTION PLAT

			0

330 Ft. from N. Line

_____ Ft. from S. Line

330 Ft. from E. Line

_____ Ft. from W. Line

Location _____

Rig up _____

Drilling and Remarks:

POT 1914
nat.

RECORD

Cased _____ in., _____ ft.

Sand 511-3278

Gas _____

Oil _____

Total Depth 3286

PRODUCTION

1st 24 hrs. Nat. _____

1st 24 hrs. after shot _____

Gas _____ Cu. Ft.

Dry Hole _____

Abandoned _____

Date

APR 28 1937 19

H. Hatfield Scout