


Section 36 Township 17 Range 11-~~W~~

Well No. 8 Patzner "A"

Company Spencer & Yarnell

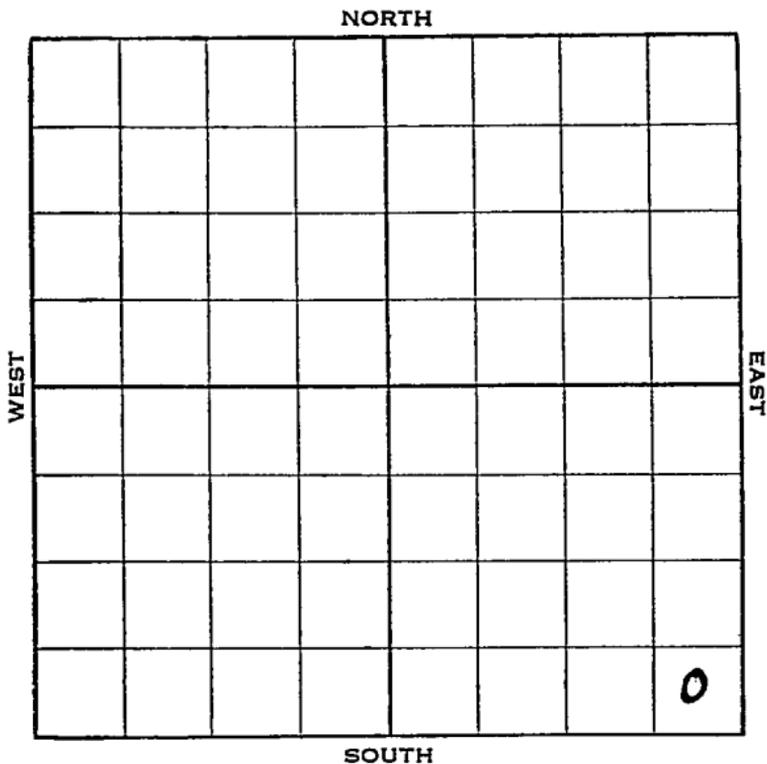

Sec. 36 Twp. 17 R. 11-W


Well No. #8 Patzner "A" Farm  
Spencer & Yarnell Company

\_\_\_\_\_ Ft. from N. Line

330 Ft. from S. Line

330 Ft. from E. Line

\_\_\_\_\_ Ft. from W. Line

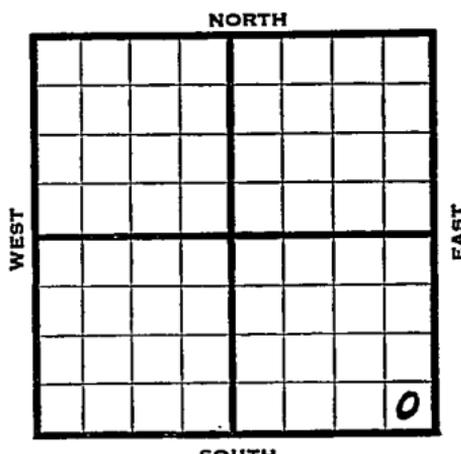

Elev. 1808'

1938	REPORT
10/5	RUCT.
10/14	15" - 175'. 12" - 560'. Dlg. 1080'.
10/21	Anhy 555'. 10" - 1932'. SD Rep. 1970'.
10/28	8" - 2237'. Dlg. 2315'.
11/4	Lans. 2950'. S. O. 2967-84'. 7" - 2976'. C. O.
11/12	7" - 3100'. Dlg. 3112'.
11/18	T. D. 3225'. U. R. 7".
11/25	7" - 3205'. Cong. 3231'. T. D. 3279'. No Arb. Will P. B.
12/2	" "
	OVER.

1938

12/7

Lans. 2950'.

Cong. 3231'.

T. D. 3279'.

No Arb.

P. B. to 3003'. 7" - 2960'?

5000 acid.

Flow 47 bbls. 8 hrs. with

2½ M gas.

Potential 141 bbls. .

**COMPLETED**

Barton **KANSAS**

Map No. 35 Sec. 36 Twp. 17 R. 11W

Well No. 8 Patzner "A"

Spencer & Yarnell

Company

Contractor

**FIRST REPORT**

SE/C

\_\_\_\_\_ Ft. from N. Line

330 Ft. from S. Line

330 Ft. from E. Line

\_\_\_\_\_ Ft. from W. Line

**SECTION PLAT**

			o

Location \_\_\_\_\_

**RECORD**

Cased \_\_\_\_\_ in., \_\_\_\_\_ ft.

Sand \_\_\_\_\_

Gas \_\_\_\_\_

Oil \_\_\_\_\_

Total Depth \_\_\_\_\_

**PRODUCTION**

1st 24 hrs. Nat. \_\_\_\_\_

1st 24 hrs. after shot \_\_\_\_\_

Gas \_\_\_\_\_ Cu. Ft.

Dry Hole \_\_\_\_\_

Abandoned \_\_\_\_\_

Rig up \_\_\_\_\_

Drilling and Remarks:

**RUCT**

Date

OCT 5 - 1938

19

H. D. Hatfield

Scout

Map No. 55 Sec. 36 Twp. 17 R. 11WWell No. 8 Patzner "A"Spencer & Yarnell

Company

Contractor

## COMPLETED

SE/C

       Ft. from N. Line330 Ft. from S. Line330 Ft. from E. Line       Ft. from W. Line

## SECTION PLAT

			0

Location       Rig' up       

Drilling and Remarks:

LANS 2950CONG 3231T.D. 3279 NO Arb.P.B. 3003 7" - 2960?5000 AcidF-47/8 w/ 2 1/2 mgasPOT 141

## RECORD

Cased        in.,        ft.Sand       Gas       Oil       Total Depth 3279

## PRODUCTION

1st 24 hrs. Nat.       1st 24 hrs. after shot       Gas        Cu. Ft.Dry Hole       Abandoned       

Date

DEC 7 - 1938

19

H. D. Hatfield

Scout