

KANSAS

Form 51-5M-7-39-Palace


Barton

Section 36 Township 17 Range 11-W

Well No. #9 Patzner "A"

Company Spencer & Yarnell

NORTH **Bloomer Pool**

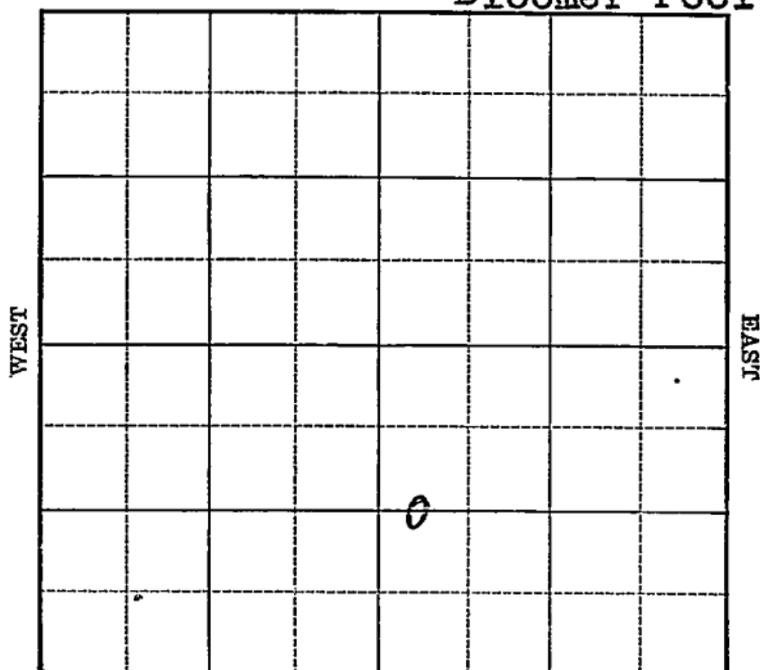

SOUTH

Sec. 36 Twp. 17 R. 11-W

Well No. #9 Patzner "A" Farm

Spencer & Yarnell Company

(Bloomer)


1320 Ft. from N. Line

_____ Ft. from S. Line

_____ Ft. from E. Line

330 Ft. from W. Line

Elev. 1808

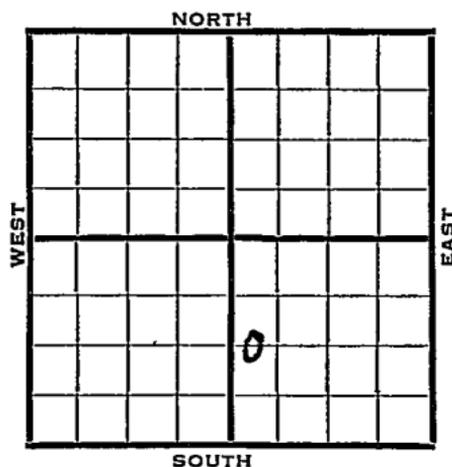

1940	REPORT
5/22	Cable.
5/29	Rigging up.
6/6	15" - 180' 12 1/2" - 244' Anhy 577' U.R. 12 1/2".
6/13	12" - 574' Drlg. 1620'
6/20	10" - 1940' 8" - 2304' Drlg. 2550'
6/27	K.C. 2955' S.O. & Gas 2975-85' Run 7" - 3208'
7/3	Arb. 3249' S.O. 3249-50' 7" - 3249' At 3254' H.F.O. 500 acid.
7/10	Arb. 3249' 7" - 3249' T.D. 3254' 500 acid. Echometer potential 2980 bbls.
COMPLETED	

Map No. 55 Sec. 36 Twp. 17 R. 11WWell No. 9 Patzner "A"Spencer & Farnell

Company

Contractor

FIRST REPORT

C W L SE

1320 Ft. from N. Line

_____ Ft. from S. Line

_____ Ft. from E. Line

330 Ft. from W. Line

BLOOMER POOL

SECTION PLAT

Location _____

Rig up _____

Drilling and Remarks:

Cable

RECORD

Cased _____ in., _____ ft.

Sand _____

Gas _____

Oil _____

Total Depth _____

PRODUCTION

1st 24 hrs. Nat. _____

1st 24 hrs. after shot _____

Gas _____ Cu. Ft.

Dry Hole _____

Abandoned _____

Date

MAY 22 1940 19S. J. LEWIS

Scout

Map No. _____ Sec. 36 Twp. 17 R. 11W

Well No. 9 Patzner "A"

Spencer & Yarnell Company

Contractor

COMPLETED

C W L SE

1320 Ft. from N. Line

_____ Ft. from S. Line

_____ Ft. from E. Line

330 Ft. from W. Line

SECTION PLAT

BLOOMER POOL

Location _____

Rig up _____

Drilling and Remarks:

cut 3249

7" @ 3249

500 acid

Exprometed Prod

2988

RECORD

Cased _____ in., _____ ft.

Sand _____

Gas _____

Oil _____

Total Depth 3254

PRODUCTION

1st 24 hrs. Nat. _____

1st 24 hrs. after shot _____

Gas _____ Cu. Ft.

Dry Hole _____

Abandoned _____

Date

JUL 10 1940 19

S. J. LEWIS

Scout