


Ellis

KANSAS

Section 19 Township 12 Range 16W

Well No. #1 Weigel

Company W. E. Wickizer

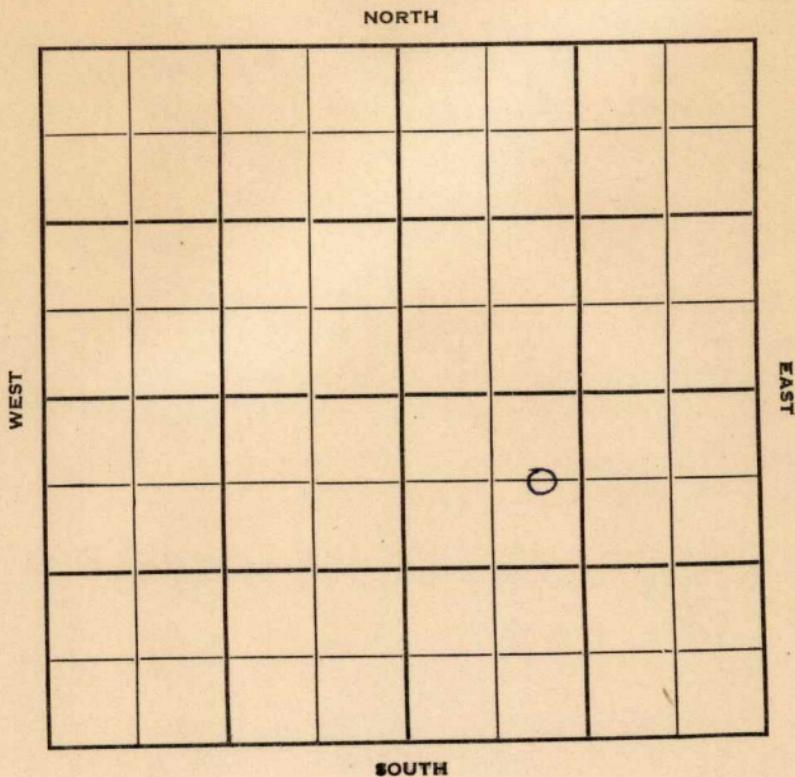

Sec. 19 Twp. 12 R. 16W

Well No. #1 Weigel Farm

W. E. Wickizer Company

Glen Nye Drlg. Contractor


660' Ft. from N. Line

\_\_\_\_\_ Ft. from S. Line

\_\_\_\_\_ Ft. from E. Line

990' Ft. from W. Line

C E L NW SE

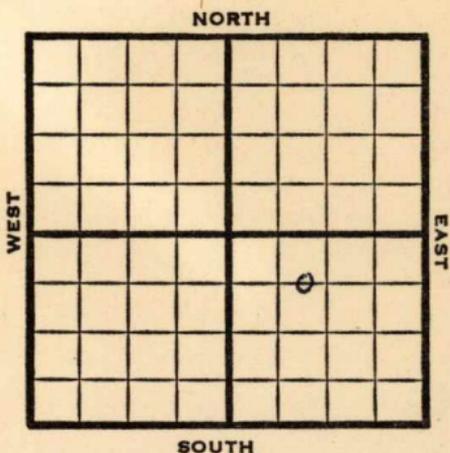

1950 **Elev. 2087'** REPORT

5/3 Spud 4-28-50  
8" @ 136'  
**Anhy 1265'**  
Drlg. 1540'

5/24 8" @ 136'  
**Anhy 1265'**  
**Heebner 3278'**  
**Lans. 3326'**  
**Arb. 3607'**  
DST 3608-17 opn 15 min.  
Rec. 70' mud  
TD 3628'  
D&A

**ABANDONED**

Kansas

Map No. \_\_\_\_\_ Sec. 19 Twp. 12 R. 16W

Well No. 1 Weigel

W. E. Wickizer Company

Glen Nye Drlg. Contractor

C E L NW SE

E1. 2087  
SECTION PLAT

660 Ft. from N. Line

\_\_\_\_\_ Ft. from S. Line

\_\_\_\_\_ Ft. from E. Line

990 Ft. from W. Line



Ellis County

Location \_\_\_\_\_

Rig up \_\_\_\_\_

Drilling and Remarks:

Spud 4-28-50

8" @ 136

Anhy 1265

drlg. 1540

RECORD

Cased \_\_\_\_\_ in., \_\_\_\_\_ ft.

Sand \_\_\_\_\_

Gas \_\_\_\_\_

Oil \_\_\_\_\_

Total Depth \_\_\_\_\_

PRODUCTION

1st 24 hrs. Nat. \_\_\_\_\_

1st 24 hrs. after shot \_\_\_\_\_

Gas \_\_\_\_\_ Cu. Ft.

Dry Hole \_\_\_\_\_

Abandoned \_\_\_\_\_

Date

MAY 3 1950 19

J. E. TYRA Scout

Kansas

Map No. \_\_\_\_\_ Sec. 19 Twp. 12 R. 16<sup>W</sup>

Well No. 1 Weigel

W. E. Wickizer Company

Contractor

C E L NW SE

E1.2087

SECTION PLAT

660 Ft. from N. Line

\_\_\_\_\_ Ft. from S. Line

\_\_\_\_\_ Ft. from E. Line

990 Ft. from W. Line

ABANDONED			
		o	

Ellis

Location \_\_\_\_\_

Rig up \_\_\_\_\_

Drilling and Remarks:

8" C 136  
 anhy 1265  
 Hubner 3278  
 Lans. 3326  
 arb. 3607  
 DST 3608-17  
 open 15 min.  
 Rec. 70' mud  
 T.D. 3628  
 Date D+A

RECORD

Cased \_\_\_\_\_ in., \_\_\_\_\_ ft.

Sand \_\_\_\_\_

Gas \_\_\_\_\_

Oil \_\_\_\_\_

Total Depth \_\_\_\_\_

PRODUCTION

1st 24 hrs. Nat. \_\_\_\_\_

1st 24 hrs. after shot \_\_\_\_\_

Gas \_\_\_\_\_ Cu. Ft.

Dry Hole \_\_\_\_\_

Abandoned \_\_\_\_\_

MAY 24 1950

J. E. TYRA Scout