


Section 20 Township 12 Range 16W

Well No. #1 Hoff

Company Coppinger

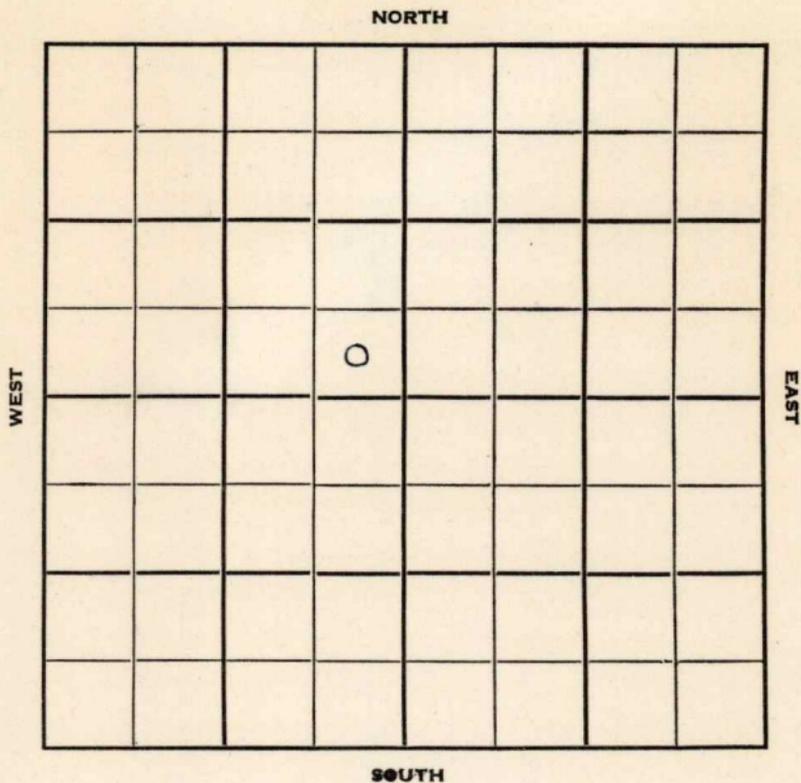

Ellis

KANSAS 16W ✓

Sec. 20 Twp. 12 R. 16W

Well No. #1 Hoff Farm

Coppinger Company

Wildcat Contractor


Ft. from N. Line

330' Ft. from S. Line

330' Ft. from E. Line

Ft. from W. Line

SE SE NW

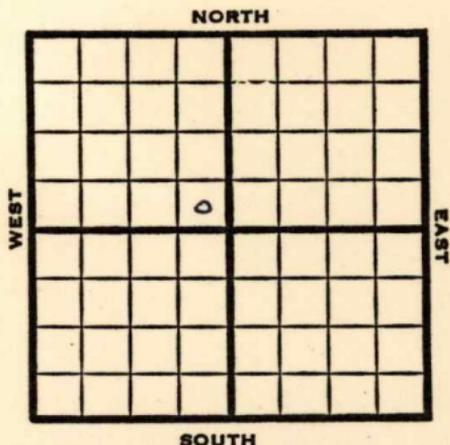

1950 Elv. 2140' REPORT

12/20 Location

1951

1/10

D&A TD 3725
8" @ 289 Heeb. 3326
Lans. 3370 Cong. 3651
Arb. 3686 TD 3725
D&A

ABANDONED


County **Ellis** State **Kansas**

Sec. **20** (Blk.) **12** (Sur.) **16W** Map No.

Operator **Coppinger**

Well No. **1** Farm **Hoff**

Elev. Location **SE SE NW**

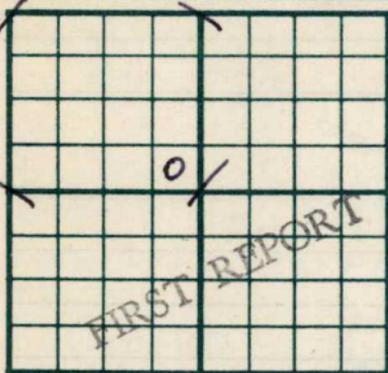

330 Ft. From **S** Line **NW**

330 Ft. From **E** Line Quarter

1st. Report **DEC 20 1950**

Completion

Remarks

Spudding Date

Drlg. Data **Wildcat**

Location


County Ellis State Kansas

Sec. 20 (Blk. Twp.) 12 (Sur. Rge.) 16W Map No.

Operator Coppinger

Well No. 1 Farm Hoff

Elev. 2140 Location SE SE NW

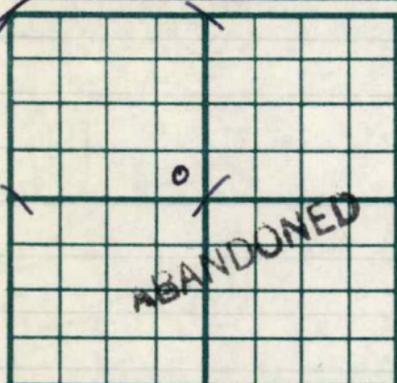

330 Ft. From S Line NW

330 Ft. From E Line Quarter

1st. Report

Completion JAN 10 1951

Remarks Wildcat

Spudding Date

Drlg. Data D & A TD 3725

8" @ 289 Heeb. 3326 Lans. 3370

Cong. 3651 Arb. 3686 TD 3725

D & A

J. E. TYRA