

Section 3 Township 17 Range 12W

Well No. 1 Long \_\_\_\_\_

Company Millard Drlg. et al

NORTH

5

WEST

0							

EAST

SOUTH

Barton

Sec. 3 Twp. 17 R. 12W

Well No. #1 Long Farm \_\_\_\_\_

Mallard Drlg. et al Company \_\_\_\_\_

Mallard Drlg. Contractor \_\_\_\_\_


\_\_\_\_\_ Ft. from N. Line

330 Ft. from S. Line

\_\_\_\_\_ Ft. from E. Line

330 Ft. from W. Line

SW SW NW

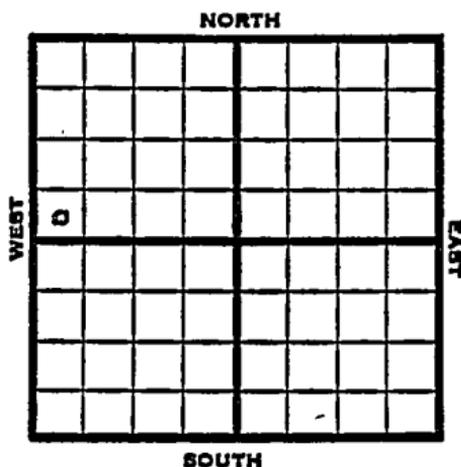

1953

Elev. 1853' REPORT

1/28

Location

2/5

8" @ 243  
Drlg. 1850'

2/12

Heeb 2946' Br li 3037' Lans 3053'  
Arb. 3308' RTD 3309 1/2 5" @ 3308

2/19

DD 3312' FU 1000' oil, some wtr.  
POP

2/25

Spud 1-30-53 Oil well TD 3312  
8" @ 243 Heeb 2946 Br line 3037  
Lans 3053 Arb 3308  
TD 3309 5" @ 3308 DD 3312  
FU 1000' oil & SW  
Comp. 50 BOPD

**COMPLETED**

County Barton State Kansas

Sec. 3 (Blk. Twp.) 17 (Sur. Rge.) 12W Map No.

Operator Mallard Drig. etal.

Well No. I Farm Long

Elev. \_\_\_\_\_ Location SW SW NW


330 Ft. From S Line NW

330 Ft. From W Line Quarter

Ist. Report JAN 28 1953

Completion \_\_\_\_\_

Remarks \_\_\_\_\_

Mallard Drig. - Contr.

Spudding Date \_\_\_\_\_

Drig. Data \_\_\_\_\_

Location

County Barton State Kansas

Sec. 3 (Blk. 17 (Sur. 12W Map No.  
Twp. Rge.)

Operator Mallard Drlg. etal.

Well No. 1 Farm Long

Elev. 1853 Location SW SW NW


330 Ft. From S Line NW

330 Ft. From W Line Quarter

Ist. Report

Completion FEB 25 1953

Remarks

Mallard Drlg. - Contr.

Spudding Date 1-30-53

Drlg. Data Oil well TD 3312

8" @ 243 Heeb. 2946 Br. lime 3037

Lans. 3053 Arb. 3308 TD 3309

5" @ 3308 DD 3312 FU 1000' oil & sw

Comp. 50 bopd