

Ellis

KANSAS


SECTION 3 TOWNSHIP 12 RANGE 17W

WELL NO. #1 Windholz "B"

COMPANY Mallonee

NORTH

C W/2 E/2 SE

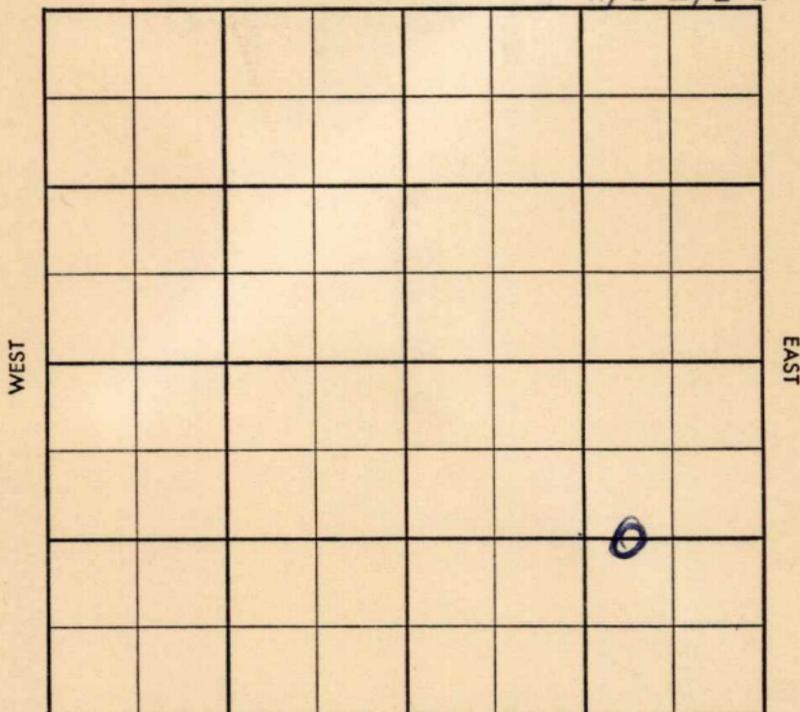

SOUTH

CO. ~~Ellis~~ ELEV. 2102.00
SEC. 3 TWP. 12 RGE. 17W
COMPANY Mallonee NO. 1

COMPLETE

NOV 27 '57

FARM Windholz "B"

LOC. C W 1/2 E 1/2 SE

A 1304
A 3278
A 3326
A 3589
TD 3661

GEOL.
CONTR. Co. tools
POOL Bemis-Shutts
SPUD 10-5-57
8" @ 212/125 drlg. 900
OCT 16 '57 DST 3398
3420 60" 180'
GIP 210' 40' 60"
725' MW BHP
883 ϕ 3428

~~OCT 23 '57~~ DST 3591 - 3605 60"
12' M BHP 114 DST 3591 - 3620
60" 22' M BHP 0 DST 3591
- 3651 60" 55' M BHP 126
5 1/2" 3659 WOL OCT 30 '57 NOV 6 '57

OCT 23 '57 NOV 20 '57 CO 3630 60/3601
- 89 A 1/2 90 ϕ h 4 hrs PB
3598 16/3590-94 B \$ 3 Boph
14 hrs
25 BOP ϕ & NW

Log tops
Ly 3326 A 3589

ark 3590 - 94 NOV 27 '57

CO.
LSE.
NO.
SEC.
TWP.
RGE.