

KANSAS


Ellis

Section 3 Township 12 Range 17W

Well No. 1 Windholtz "B"

Company Westgate-Greenland

Bemis

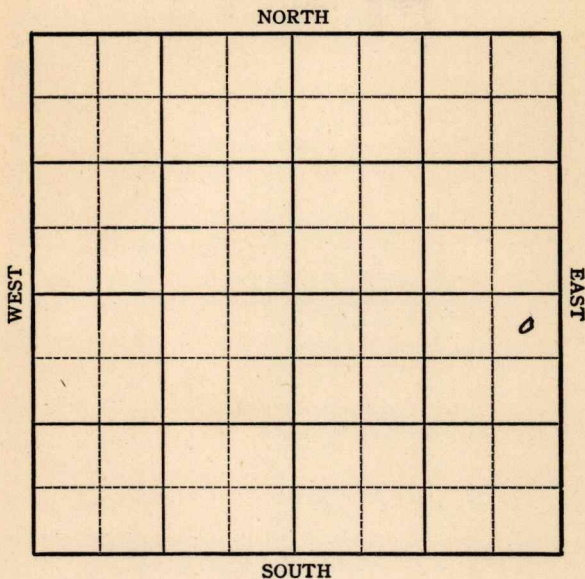

KANSAS

Ellis

Sec. 3 Twp. 12 R. 17W ✓

Well No. #1 Windholtz "B" Farm

Westgate-Greenland Company


Bemis Pool

330' Ft. from N. Line

_____ Ft. from S. Line

330' Ft. from E. Line

_____ Ft. from W. Line

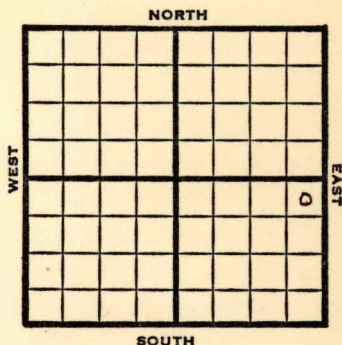

NE SE

1949

Elev 2115'

REPORT

3/9

Location

3/16

9" @ 190'

Drlg 2570'

3/23

Arbuckle 3762'

Drlg. 3764'

3/30

Lans 3343'

Arb. 3762'

TD 3811'

ABANDONED

Kansas

Map No. _____ Sec. 3 Twp. 12 R. 17WWell No. 1 Windholtz "B"Westgate-Greenland CompanyFIRST REPORT Contractor

NE SE


SECTION PLAT

330 Ft. from N. Line

_____ Ft. from S. Line

330 Ft. from E. Line

_____ Ft. from W. Line

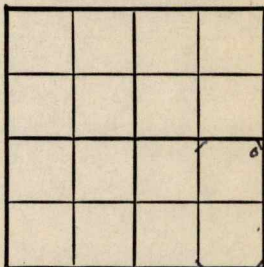

Ellis County

Location X

Rig up _____

Drilling and Remarks:

RECORD

Cased _____ in., _____ ft.

Sand _____

Gas _____

Oil _____

Total Depth _____

PRODUCTION

1st 24 hrs. Nat. _____

1st 24 hrs. after shot _____

Gas _____ Cu. Ft.

Dry Hole _____

Abandoned _____

Date

MAR 9 1949 19S. J. LEWIS

Scout

Map No. 71 Sec. 3 Twp. 12 R. 17W

Well No. 1 Windholtz "B"

Westgate-Greenland

Company

ABANDONED

Contractor

NE SE

E12119
SECTION PLAT

330 Ft. from N. Line

_____ Ft. from S. Line

330 Ft. from E. Line

_____ Ft. from W. Line

			0

Ellis County

Location _____

Rig up _____

Drilling and Remarks:

Lane 8343

Cur 8762.

RECORD

Cased _____ in., _____ ft.

Sand _____

Gas _____

Oil _____

Total Depth 2871

PRODUCTION

1st 24 hrs. Nat. _____

1st 24 hrs. after shot _____

Gas _____ Cu. Ft.

Dry Hole _____

Abandoned _____

Date

MAR 30 1949

19

S. J. LEWIS

Scout