

KANSAS

Ellis

Section 3 Township 12 Range 17W

Well No. 2 Windholtz

Company Westgate-Greenland

Bemis

NORTH

WEST

EAST

SOUTH

KANSAS Ellis

Sec. 3 Twp. 12 R. 17W ✓

Well No. #2 Windholtz Farm

Westgate-Greenland Company

Bemis Pool

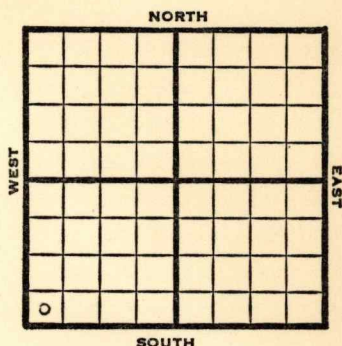
 Ft. from N. Line

330' Ft. from S. Line

 Ft. from E. Line

330' Ft. from W. Line

SW/C



1949 **Elev 2086'** REPORT

3/30	9" @ 191'
	Anhy 1295'
	Drlg. 1470'
4/6	Drlg 3290'
4/12	Heebner 3266'
	Lansing 3310'
	Arb. 3576'-86'
	TD 3586'
	5"@ 3583'
4/20	TD 3596'
	1000 acid
4/27	Plug 3375
	30 shots 3360-70
	Swb 5 bbls oil PH SW
5/4	"
5/10	"
5/18	"
5/25	"
6/1	TD 3586'
	Lans. 3310'
	Arb. 3576'
	5"@ 3583'
	Perf Lans.
	1000 acid
	Pump 57 Oil + 28% wtr. Pot
	36° Gr.
	Comp

COMPLETED

Kansas

Map No. _____ Sec. 3 Twp. 12 R. 17WWell No. 2 WindholtzWestgate-Greenland

Company

FIRST REPORT

Contractor

SW/C

SECTION PLAT

_____ Ft. from N. Line

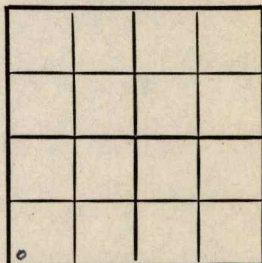
330

_____ Ft. from S. Line

_____ Ft. from E. Line

330

_____ Ft. from W. Line

Ellis County

Location _____

Rig up _____

Drilling and Remarks:

9" @ 191

Anhy 1295

drlg. 1470

RECORD

Cased _____ in., _____ ft.

Sand _____

Gas _____

Oil _____

Total Depth _____

PRODUCTION

1st 24 hrs. Nat. _____

1st 24 hrs. after shot _____

Gas _____ Cu. Ft.

Dry Hole _____

Abandoned _____

Date

MAR 30 1949S. J. LEWIS

Scout

Kansas

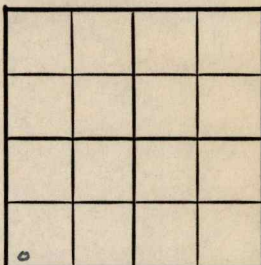
Bemis Pool

Map No. K71 Sec. 3 Twp. 12 R. 17WWell No. 2 WindholtzWestgate-Greenland Company

COMPLETE

Contractor

SW/C

E12076
SECTION PLAT Ft. from N. Line330 Ft. from S. Line Ft. from E. Line330 Ft. from W. Line

Ellis County

Location Rig up

Drilling and Remarks:

water pay

RECORD

Cased in., ft.Sand Gas Oil Total Depth 3586

PRODUCTION

1st 24 hrs. Nat. 1st 24 hrs. after shot Gas Cu. Ft.Dry Hole Abandoned

Date

36 2/24

JUN 1 1949

19

S. J. LEWIS

Scout